

Perry
E 29
11/18/77

MISSISSIPPI
BOARD OF WATER COMMISSIONERS
416 North State Street
Jackson, Mississippi 39201

CODED

WATER WELL DRILLERS LOG

11/18/77 19 Griner Drilling Service Perry County
date well completed firm name county well located

LANDOWNER: Louisiana Land
Exploration #1 Gerald L.
Reason Estate
(mailing address)

description of formations encountered	from	to
Hard Clay	0	21
Hard Clay	21	42
Clay w/ streaks of Sand	43	63
Clay on sand w/ streaks	64	84
Sand with streaks of Clay	85	105
Clay with Sand streaks	106	126
Clay with streaks of Sand	127	147
Clay with streaks of Sand	148	168
110 " " " " "	169	189
Clay with a streak of Sand	190	210
117 " " " " "	211	231
Clay with CODED streaks of Sand	232	252
Clay " " " " "	253	273
Clay " " Streaks of Sand	274	294
Streaks of Clay & Sand	295	315
Clay w/ Sand streak	316	336
of Clay	337	357
Clay with 10' of Sand	358	378
Sand	379	399
Sand	400	420
Sand with streak of Clay	421	441

WELL LOCATION:
1 sec. 34 T 4 N R 10 E
660' St 660' W of NE corner of Richton, MS
(distance) miles (direction) of (nearest town)

WELL PURPOSE:
(home, irrigation, municipal, industrial)

WELL COMPLETION DATA:
(1) diameter (inches) 4"
(2) total depth (feet) 441'
(3) static water level (feet) 30' below above top of ground.
(4) casing Steel 420'
(material) (depth)
(size) If telescope see back.
(5) screen 42' 368'
(length) (depth to top)
4" Perforated Pipe
(size) (material)
(6) pump 85
(HP) (yield gpm)
A.C.
(type power)
(7) electric log NO
(yes or no)
(organization running log)

(8) how well bottom plugged Orange
peel

DRILLERS REMARKS:


RECEIVED

NOV 25 1977

MISS. BD. OF WATER COMM

If well telescopes please sketch and show depths.

GROUND LEVEL

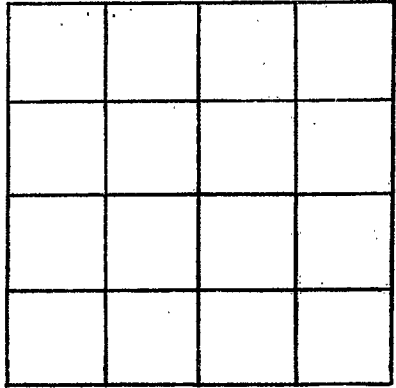

SECTION _____

Please indicate well location X.

ADDITIONAL INFORMATION

If more than one screen,
show locations of each on sketch.