

MISSISSIPPI
BOARD OF WATER COMMISSIONERS
416 North State Street
Jackson, Mississippi 39201

WATER WELL DRILLERS LOG

CODED

Perry
E 34
8-16-71

8-16
date well completed

1971 Robertson's
firm name

PERRY
county well located

LANDOWNER: MR. H. O. WEAVER	description of formations encountered	from	to
	SANDY CLAY	0	3
RT 3 Box 10 Richton (mailing address)	Blue + WHITE CLAY	3	22 28
	FINE SAND	8	22
	Blue Clay	22	27
WELL LOCATION: sec. 8 T. 4 N. R. 10 E. S W	SAND + PA	27	33
5 miles SW of Richton (distance) (direction) (nearest town)	CWB SAND	33	55
WELL PURPOSE: (home) Irrigation, municipal, industrial			
WELL COMPLETION DATA:			
(1) diameter (inches) 4"			
(2) total depth (feet) 55			
(3) static water level (feet) 22 below above top of ground.			
(4) casing plastic 45 (material) (depth)			
4" (size) if telescope see back.			
(5) screen 10 45 (length) (depth to top)			
4 (size) plastic (material)			
(6) pump 1 610 (HP) (yield gpm)			
Jet (type power)			
(7) electric log (yes or no)			
(organization running log)			
(8) how well bottom plugged KA 60			
DRILLERS REMARKS: # 8			


CODED

OCT 12 1971

ENCS. BD; OF
COMMISSIONERS
BOARD OF WATER

If well telescopes please sketch and show depths.

GROUND LEVEL

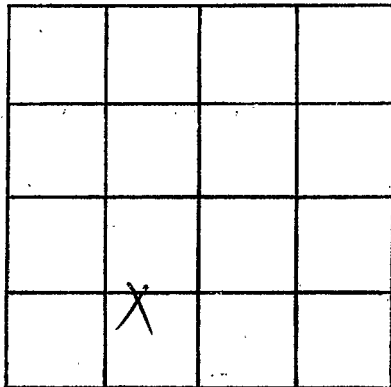

SECTION 8

Please indicate well location X.

ADDITIONAL INFORMATION

If more than one screen,
show locations of each on sketch.