

PERRY

E-41

7-10-80

July 10  
date well completed

MISSISSIPPI  
BOARD OF WATER COMMISSIONERS  
416 North State Street  
Jackson, Mississippi 39201

CODED

WATER WELL DRILLERS LOG

80 C.P. Clark Well Wells  
firm name

Perry  
county well located

LANDOWNER:	description of formations encountered	from	to
Rubin Pitman <del>Rubin Pitman</del>	Sand sand	0	12
Rte 1, Box 313, Beaumont MS (mailing address)	Sand and blue gravel	12	25
	White to lilac clay	25	85
	Blue-green clay	85	210
	with streaks		
	clay w/ sand streaks	210	241 1/2
	Sand	241 1/2	243
	clay w/ sand streaks	243	258
	Sand	258	268
	clay	268	270
<b>WELL LOCATION:</b>			
sec. 36 T 4 N R 10 E			
7 1/2 miles N-NW of Beaumont (distance) (direction) (nearest town)			
<b>WELL PURPOSE:</b> home (home, irrigation, municipal, industrial)			
<b>WELL COMPLETION DATA:</b>			
(1) diameter (inches)	2		
(2) total depth (feet)	268		
(3) static water level (feet)	125 below top of ground.		
(4) casing (material)	Galv. 258' (depth)		
	If telescope see back. (size)		
(5) screen (length)	10, 258' (depth to top)		
	1 1/4" stainless (size) (material)		
(6) pump (HP)	1 1/2, 5 1/2/20# (yield gpm)		
	220V. (type power)		
(7) electric log (yes or no)	no		
	(organization running log)		
(8) how well bottom plugged	BWW		
<b>DRILLERS REMARKS:</b> make good well, no odor, water clean, good taste			

DEPT. OF NATURAL RESOURCES  
BUREAU OF LAND & WATER RESOURCES


JUL 22 1980

RECEIVED

8A Jet set @ 121 ft  
Red Jacket  
Jet pump  
1 1/2 HP

If well telescopes please sketch and show depths.

GROUND LEVEL

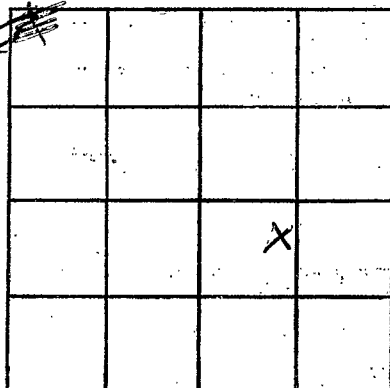

SECTION 34

Please indicate well location X.

ADDITIONAL INFORMATION

If more than one screen, show locations of each on sketch.