

PERRY

E-42

6-17-80

June 17

MISSISSIPPI
 BOARD OF WATER COMMISSIONERS
 416 North State Street
 Jackson, Mississippi 39201

CODED

WATER WELL DRILLERS LOG

1980 Roy West Drig Perry

date well completed

firm name

county well located

LANDOWNER:	description of formations encountered	from	to
Noel Matthews LAWREL MS 39440 (mailing address)			
WELL LOCATION:			
sec. <u>7</u> T. <u>4</u> N. R. <u>10</u> E. W. <u>5</u>			
<u>2</u> <u>1</u> <u>20</u> miles <u>E</u> of <u>Runnels town</u> (distance) (direction) (nearest town)			
WELL PURPOSE: <u>INDUSTRIAL</u> (home, irrigation, municipal, industrial)			
WELL COMPLETION DATA:			
(1) diameter (inches) <u>4"</u>			
(2) total depth (feet) <u>100'</u>			
(3) static water level (feet) <u>25'</u> below above top of ground.			
(4) casing <u>PVC</u> , <u>80'</u> (material) (depth)			
(size) If telescope see back.			
(5) screen <u>20'</u> , <u>80'</u> (length) (depth to top)			
<u>4"</u> , <u>PVC</u> (size) (material)			
(6) pump <u>1</u> , <u>30</u> (HP) (yield gpm)			
<u>REA</u> (type power)			
(7) electric log <u>no</u> (yes or no)			
(organization running log)			
(8) how well bottom plugged <u>WASH VALVE</u>			
DRILLERS REMARKS:			

CODED


DEPT. OF NATURAL RESOURCES
 BUREAU OF LAND & WATER RESOURCES

JUL 16 1980

RECEIVED

If well telescopes please
sketch and show depths.

GROUND LEVEL

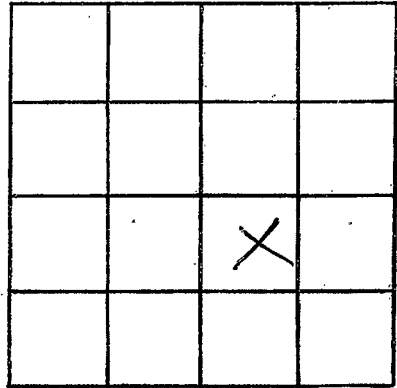

SECTION _____

Please indicate well location X.

ADDITIONAL INFORMATION

If more than one screen,
show locations of each on sketch.