

PERRY  
E 2000  
4-14-76

MISSISSIPPI  
BOARD OF WATER COMMISSIONERS  
416 North State Street  
Jackson, Mississippi 39201

WATER WELL DRILLERS LOG

4-14-1976 date well completed  
130  
76 Rural Drilling Ser. firm name  
Perry county well located

LANDOWNER:	description of formations encountered	from	to
J.C. Hillman P.O. Office, Richton Miss (mailing address)	Clay sand & gravel	0	16
	Dec. sand & sand	16	30
	Hard sand	30	50
		50	90

WELL LOCATION:  
sec. 7 T. 15 N. R. 10 E. S. 1 W.  
1 miles W of Richton  
(distance) (direction) (nearest town)

WELL PURPOSE: Home  
(home, irrigation, municipal, industrial)


- WELL COMPLETION DATA:
- (1) diameter (inches) 2"
  - (2) total depth (feet) 70 ft
  - (3) static water level (feet) 55 ft below above top of ground.
  - (4) casing plastic, 65 ft,  
(material) (depth)  
2" If telescope see back.  
(size)
  - (5) screen 5 ft, 70 ft  
(length) (depth to top)  
2", plastic  
(size) (material)
  - (6) pump 1 8  
(HP) (yield gpm)  
jet  
(type power)
  - (7) electric log ✓  
(yes or no)  
✓  
(organization running log)
  - (8) how well bottom plugged plugged

DRILLERS REMARKS:

REGISTERED  
MAY 25 1976  
MISSISSIPPI BOARD OF WATER COMMISSIONERS

If well telescopes please sketch and show depths.

GROUND LEVEL

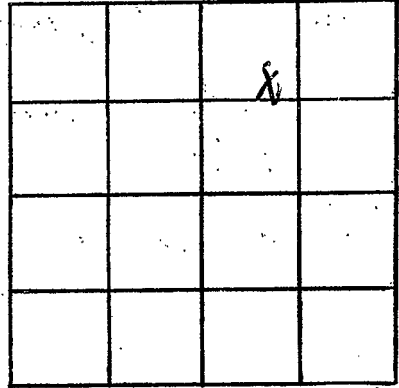

SECTION \_\_\_\_\_

Please indicate well location X.

ADDITIONAL INFORMATION

If more than one screen, show locations of each on sketch.