

PERRY
E
2001

**MISSISSIPPI  
BOARD OF WATER COMMISSIONERS**  
416 North State Street  
Jackson, Mississippi 39201

**WATER WELL DRILLERS LOG**

June 23 1978 Roy v v v water well Perry  
 date well completed      firm name      county well located

<b>LANDOWNER:</b> J. M. Conner	description of formations encountered	from	to
Rt 3 Box 142 Richton, MS (mailing address)			
	Clay	0	5
	Sand	5	40

**WELL LOCATION:**  
 sec 32 T 4 N R 10 E  
 S W  
10 miles W of Richton  
 (distance) (direction) (nearest town)

**WELL PURPOSE:** home  
 (home, irrigation, municipal, industrial)

**WELL COMPLETION DATA:**

(1) diameter (inches) 2

(2) total depth (feet) 40

(3) static water level (feet) 10 below above  
 top of ground.

(4) casing PVC 35  
 ((material) (depth)  
 (size) if telescope see back.

(5) screen 5 35  
 (length) (depth to top)  
1/4 st steel  
 (size) (material)

(6) pump 1 10  
 (HP) (yield gpm)  
RCA  
 (type power)

(7) electric log NO  
 (yes or no)

(organization running log)

(8) how well bottom plugged washed


**DRILLERS REMARKS:**

**RECEIVED**  
 RE  
 AUG - 2 1978

MISS. Bd. OF WATER COMMISSIONERS

If well telescopes please sketch and show depths.

GROUND LEVEL

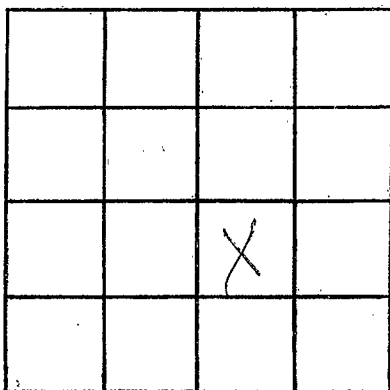

SECTION 32

Please indicate well location X.

ADDITIONAL INFORMATION

If more than one screen,  
show locations of each on sketch.