

MISSISSIPPI DEPARTMENT OF NATURAL RESOURCES
Bureau of Land and Water Resources
 Southport Mall
 P.O. Box 10631
 Jackson, Mississippi 39209
WATER WELL DRILLERS LOG

Perry
E 2002

Jan. 18, 1987 date well completed Cochran Brothers Drilling Service firm name Perry county well located

LANDOWNER:	description of formations encountered	from	to
<u>L.C. Hinton</u>			
<u>Rt. 5 Richton</u> (mailing address)	<u>Red clay</u>	<u>2</u>	<u>6</u>
<u>WELL LOCATION:</u>	<u>Red Sand</u>	<u>6</u>	<u>12</u>
sec. <u>4</u> T. <u>4</u> (N) S R. <u>10</u> E (W)	<u>Brown clay</u>	<u>12</u>	<u>18</u>
<u>5</u> miles <u>W</u> of <u>Richton</u> (distance) (direction) (nearest town)	<u>GRAY CLAY</u>	<u>18</u>	<u>29</u>
<u>WELL PURPOSE:</u> <u>home</u> (home) irrigation, municipal, industrial)	<u>SAND</u>	<u>29</u>	<u>41</u>
<u>WELL COMPLETION DATA:</u>	<u>GRAY clay</u>	<u>41</u>	<u>86</u>
(1) diameter (inches) <u>2"</u>	<u>Sand</u>	<u>86</u>	<u>100</u>
(2) total depth (feet) <u>100</u>			
(3) static water level (feet) <u>78</u> ^{below} above top of ground.			
(4) casing <u>PVC</u> , <u>95'</u> (material) (depth)			
(size) If telescope see back.			
(5) screen <u>5'</u> , <u>95'</u> (length) (depth to top)			
(size) <u>2"</u> , <u>PVC</u> (material)			
(6) pump <u>1</u> , <u>5</u> (HP) (yield gpm)			
(type power) <u>elec</u>			
(7) electric log <u>no</u> (yes or no)			
(organization running log)			
(8) how well bottom plugged <u>valve</u>			
DRILLERS REMARKS:			


DEPT. OF NATURAL RESOURCES
 BUREAU OF LAND & WATER RESOURCES

FEB 23 1987

RECEIVED

If well telescopes please
sketch and show depths.

GROUND LEVEL

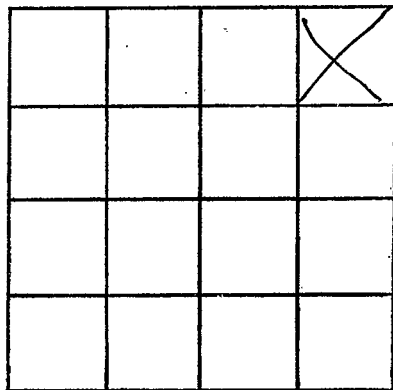

SECTION 4

Please indicate well location X.

ADDITIONAL INFORMATION

If more than one screen,
show locations of each on sketch.