

Perry  
E  
2004

MISSISSIPPI DEPARTMENT OF NATURAL RESOURCES  
 Bureau of Land and Water Resources  
 Southport Mall  
 P.O. Box 10631  
 Jackson, Mississippi 39209  
**WATER WELL DRILLERS LOG**

June 9 1982 Cochean Bio. Drilling Service Perry  
 date well completed firm name county well located

LANDOWNER:	description of formations encountered	from	to
<u>Steve Brack</u> <u>Rt 3 Richton</u> (mailing address)			
<b>WELL LOCATION:</b>			
sec. <u>2</u> T <u>5</u> N R <u>10</u> E <u>9</u> miles <u>N</u> of <u>Richton</u> (distance) (direction) (nearest town)			
<b>WELL PURPOSE:</b> ( <u>home</u> , irrigation, municipal, industrial)			
<b>WELL COMPLETION DATA:</b>			
(1) diameter (inches) <u>2"</u>			
(2) total depth (feet) <u>67'</u>			
(3) static water level (feet) <u>45</u> <u>below</u> above top of ground.			
(4) casing <u>PVC</u> , <u>62'</u> (material) (depth)			
_____ if telescope see back. (size)			
(5) screen <u>5'</u> , <u>62'</u> (length) (depth to top)			
<u>2"</u> , <u>PVC</u> (size) (material)			
(6) pump <u>1</u> , <u>5</u> (HP) (yield gpm)			
<u>elec</u> (type power)			
(7) electric log <u>no</u> (yes or no)			
_____ (organization running log)			
(8) how well bottom plugged <u>valve</u>			

DEPT. OF NATURAL RESOURCES  
 BUREAU OF LAND & WATER RESOURCES


OCT - 4 1982

RECEIVED

DRILLERS REMARKS:

If well telescopes please sketch and show depths.

GROUND LEVEL

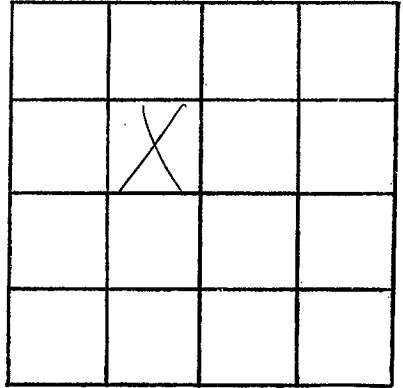

SECTION 2

Please indicate well location X.

ADDITIONAL INFORMATION

If more than one screen, show locations of each on sketch.