

MISSISSIPPI DEPARTMENT OF NATURAL RESOURCES

Bureau of Land and Water Resources

P.O. Box 10631

Jackson, Mississippi 39209

WATER WELL DRILLERS LOG

COUNTY WELL LOCATED <i>Perry</i>	
WELL NUMBER <i>E 2005</i>	CODED
DATE WELL COMPLETED <i>9-5-90</i>	

PERMIT NUMBER <i>0408</i>
NAME OF DRILLING FIRM <i>FryFogle Well Serv.</i> <i>39452</i> <i>Rt 9 Box 3 Hattiesburg MS</i>

NAME & MAILING ADDRESS OF LANDOWNER <i>Ronald V. Henderson</i> <i>Rt 1 Box 312</i>			
WELL LOCATION: SEC _____ TOWNSHIP _____ RANGE _____ <i>Hattiesburg 3674 N R 10 W</i>			
DISTANCE _____ Miles	DIRECTION <i>West</i>	NEAREST TOWN <i>Hattiesburg</i>	
OTHER LANDMARK <i>next door to Siminyo Baptist Church</i>			
WELL PURPOSE: <i>Home Irrigation, Municipal, Industrial, Fish Pond, etc.</i>			


PUMP DATA			
PUMP TYPE (Circle One): Submersible, Turbine, <input checked="" type="radio"/> Jet, Flowing Well, Other (Describe) _____			
POWER TYPE (Circle One): <input checked="" type="radio"/> Electric, Tractor, Diesel, Gasoline, Butane, Other (Describe) _____ H/P _____			
Pump Capacity (GPM) <i>10</i>	No. of Stages <i>2</i>	Setting Depth <i>120'</i> FT.	
PUMP TEST			
Well yielded <i>5</i> GPM with a drawdown of <i>? approx 5</i> ft. after <i>1/2</i> hours of pumping			

WELL DATA		
Well Depth <i>120'</i>	Casing Diameter (In.) <i>2"</i>	Casing Length (Ft.) <i>120'</i>
Type of Casing <i>PVC</i>	Hole Depth <i>120'</i>	Depth to Static Water Level <i>96'</i>
TYPE OF COMPLETION: (Circle One or More): Gravel Packed, Underreamed, Telescoped, Natural Development, <input checked="" type="radio"/> Open Hole, Other (Describe) <i>on log</i>		
Top of Lap Pipe or Reduction in Casing FEET IF TELESCOPED OR MORE THAN ONE SCREEN: USE BACK PAGE		

LOG DATA	
TYPE OF LOG RUN (Circle One): No Log Run, Electric, Gamma Ray, Density, Sonic, Neutron, Other (Describe) _____	
Name of Organization Running Log	

SCREEN DATA		
Diameter - Inches <i>2"</i>	Length - Feet <i>5'</i>	Slot Size - Inches <i>#8</i>
Screen Type <i>PVC Samed</i>	Depth to Bottom - Feet <i>14</i>	


GEOLOGIC DATA (Office Use Only)			
Surface Elev.	Geologic Unit	Unit Thickness	Depth to Top
Subs. SWL	Date	Analysis	Aquifer Test
Driller's Remarks <i>PH. 8</i> <i>Iron 6</i>			

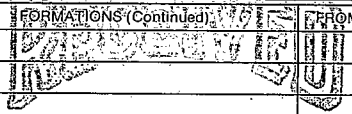DESCRIPTION OF FORMATIONS ENCOUNTERED	FROM	TO	FORMATIONS (Continued)	FROM	TO
<i>Top Soil</i>	<i>0</i>	<i>5</i>	 FEB 08 1991 Dept. of Environmental Quality Bureau of Land & Water Resources		
<i>Clay</i>	<i>5</i>	<i>20</i>			
<i>Sandy clay</i>	<i>20</i>	<i>30</i>			
<i>Streak sand</i>	<i>30</i>	<i>50</i>			
<i>Clay</i>	<i>50</i>	<i>80</i>			
<i>Sandy Packet</i>	<i>80</i>	<i>85</i>			
<i>Clay</i>	<i>85</i>	<i>110</i>			
<i>streak Spindly clay</i>	<i>110</i>	<i>120</i>			
<i>Sand</i>	<i>120</i>				

IF MORE SPACE IS NEEDED, USE BACK

If well telescopes please
sketch and show depths.

GROUND LEVEL

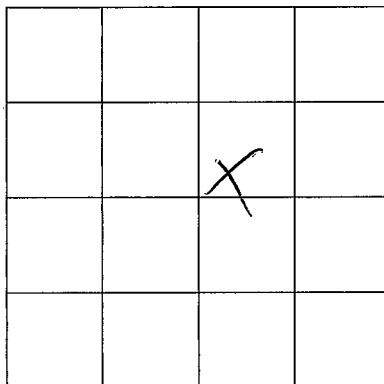

SECTION 36

Please indicate well location X.

ADDITIONAL INFORMATION

If more than one screen,
show location of each on sketch.