

Perry
F 11
7-68

MISSISSIPPI
 BOARD OF WATER COMMISSIONERS
 416 North State Street
 Jackson, Mississippi 39201

CODED

WATER WELL DRILLERS LOG

July 2 1968 Zins Drilling Perry
 date well completed firm name county well located


LANDOWNER: Z. Hinton
Richita
 (mailing address)

WELL LOCATION:
 sec. 21 T 4 N R 7 E
S W
4 1/2 miles N.NE of Winchester
 (distance) (direction) (nearest town)

WELL PURPOSE: Home
 (home, irrigation, municipal, industrial)

- WELL COMPLETION DATA:
- (1) diameter (inches) 2
 - (2) total depth (feet) 165
 - (3) static water level (feet) 32 ^{below} above top of ground.
 - (4) casing plastic, 160,
 (material) (depth)
 (size) if telescope see back.
 - (5) screen 5, 160
 (length) (depth to top)
2, plastic
 (size) (material)
 - (6) pump 1 7
 (HP) (yield gpm)
Ele.
 (type power)
 - (7) electric log No
 (yes or no)
 (organization running log)
 - (8) how well bottom plugged value


description of formations encountered	from	to
<u>Clay</u>	<u>0</u>	<u>19</u>
<u>Sand</u>	<u>19</u>	<u>24</u>
<u>Clay</u>	<u>24</u>	<u>105</u>
<u>Rock</u>	<u>105</u>	<u>107</u>
<u>Clay</u>	<u>107</u>	<u>130</u>
<u>Sand</u>	<u>130</u>	<u>165</u>

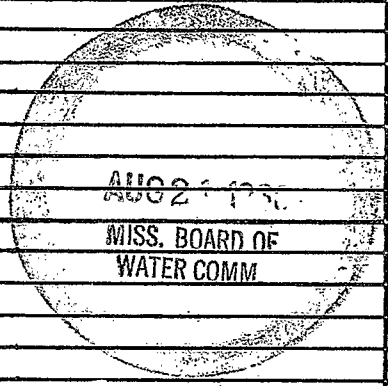

DRILLERS REMARKS:

If well telescopes please sketch and show depths.

GROUND LEVEL

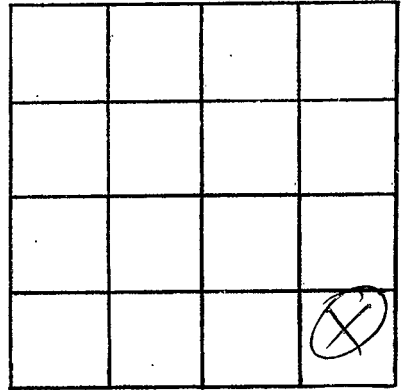

SECTION 21

Please indicate well location X.

ADDITIONAL INFORMATION

If more than one screen, show locations of each on sketch.