

Perry  
 F 12  
 7-68

MISSISSIPPI  
 BOARD OF WATER COMMISSIONERS  
 416 North State Street  
 Jackson, Mississippi 39201

CODED

WATER WELL DRILLERS LOG

July 7 1968 Time Drilling Co. Perry  
 date well completed firm name county well located


LANDOWNER:  
 Jerry Hinton  
 Richlon Route 4  
 (mailing address)

description of formations encountered	from to	
	feet	feet
Clay	0	16
Sand	16	28
Clay	28	105
Red P.	105	107
Clay	107	140
Sand	140	165

WELL LOCATION:  
 sec. 21 T. 4 S. R. 9 E.  
 4 miles N-NE of Hinton  
 (distance) (direction) (nearest town)

WELL PURPOSE: home  
 (home, irrigation, municipal, industrial)


- WELL COMPLETION DATA:
- (1) diameter (inches) 3
  - (2) total depth (feet) 165
  - (3) static water level (feet) 37 (Below) above top of ground.
  - (4) casing P.V.C. 160  
 (material) (depth)  
 (size) if telescope see back.
  - (5) screen 5 160  
 (length) (depth to top)  
2 P.V.C. Plastic  
 (size) (material)
  - (6) pump 1/2 5  
 (HP) (yield gpm)  
ele.  
 (type power)
  - (7) electric log No  
 (yes or no)  
 (organization running log)
  - (8) how well bottom plugged Water

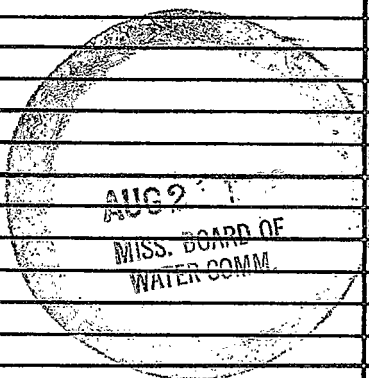

DRILLERS REMARKS:

If well telescopes please sketch and show depths.

GROUND LEVEL

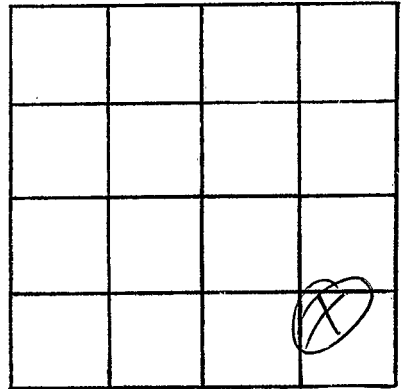

SECTION 21

Please indicate well location X.

ADDITIONAL INFORMATION

If more than one screen,  
show locations of each on sketch.