

Perry
 F 13
 7-68

MISSISSIPPI
 BOARD OF WATER COMMISSIONERS
 416 North State Street
 Jackson, Mississippi 39201

CODED

WATER WELL DRILLERS LOG

July 15 1968 Ginn Drilling Co. Perry
 date well completed firm name county well located

LANDOWNER: E. E. Moyas
Richter Miss
Route 3
 (mailing address)


WELL LOCATION:
 sec. 15 T. 4 N. R. 9 E.
S. SE. of Richter
 (distance) (direction) (nearest town)

WELL PURPOSE: farm
 (home, irrigation, municipal, industrial)

- WELL COMPLETION DATA:
- (1) diameter (inches) 2
 - (2) total depth (feet) 265
 - (3) static water level (feet) 80 ^{below} _{above} top of ground.
 - (4) casing Galv., 260,
 (material) (depth)
 _____ if telescope see back.
 (size)
 - (5) screen 5, 260
 (length) (depth to top)
2, Stainless Steel
 (size) (material)
 - (6) pump 1, 5
 (HP) (yield gpm)
Elc.
 (type power)
 - (7) electric log No
 (yes or no)

 (organization running log)
 - (8) how well bottom plugged Value


description of formations encountered	from	to
<u>Red Clay</u>	<u>0</u>	<u>20</u>
<u>Clay Shale</u>	<u>20</u>	<u>28</u>
<u>Blue Clay</u>	<u>28</u>	<u>95</u>
<u>Sand</u>	<u>95</u>	<u>104</u>
<u>Blue Clay</u>	<u>104</u>	<u>190</u>
<u>Red Gravel</u>	<u>190</u>	<u>192</u>
<u>Blue Clay</u>	<u>192</u>	<u>250</u>
<u>Sand</u>	<u>250</u>	<u>265</u>

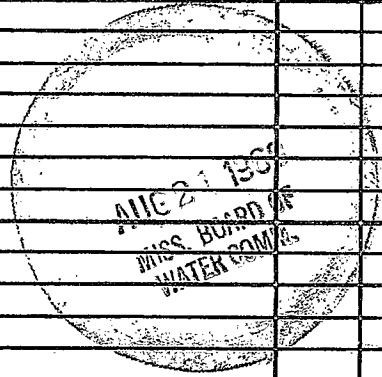

DRILLERS REMARKS:

If well telescopes please sketch and show depths.

GROUND LEVEL

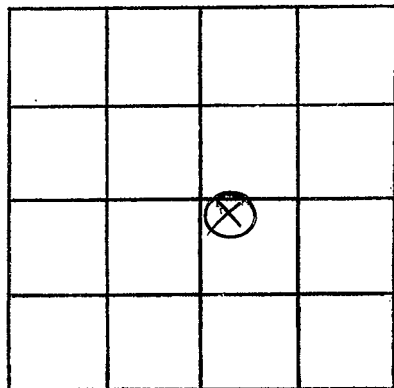

SECTION 15

Please indicate well location X.

ADDITIONAL INFORMATION

If more than one screen, show locations of each on sketch.