

Perry
 F 14
 9-15-68

MISSISSIPPI
 BOARD OF WATER COMMISSIONERS
 416 North State Street
 Jackson, Mississippi 39201

CODED
 CODED
WATER WELL DRILLERS LOG

Sep. 15 19 *68* *Lins Drilling, Perry*
 date well completed firm name county well located

LANDOWNER: *Hinton*

description of formations encountered	from	to
	<i>Clay</i>	<i>0</i>
<i>Sand</i>	<i>17</i>	<i>24</i>
<i>Clay</i>	<i>24</i>	<i>35</i>
<i>Sand</i>	<i>35</i>	<i>41</i>
<i>Clay</i>	<i>41</i>	<i>75</i>
<i>Sand</i>	<i>75</i>	<i>119</i>
<i>Clay</i>	<i>119</i>	<i>128</i>
<i>Sand</i>	<i>128</i>	<i>155</i>

New Augusta
 (mailing address)

WELL LOCATION:
 sec. *33* T *4* N R *9* E
4 miles *E* of *Hinton* (nearest town)


WELL PURPOSE: *none*
 (home, irrigation, municipal, industrial)

- WELL COMPLETION DATA:
- (1) diameter (inches) *2 1/2*
 - (2) total depth (feet) *155*
 - (3) static water level (feet) *40* (below top of ground)
 - (4) casing *PVC* (material), *150* (depth)
 (size) if telescope see back.
 - (5) screen *5* (length), *150* (depth to top)
2 (size), *PVC* (material)
 - (6) pump *3/4* (HP), *5* (yield gpm)
Electric (type power)
 - (7) electric log *No* (yes or no)

(organization running log)


(8) how well bottom plugged *None*

DRILLERS REMARKS:

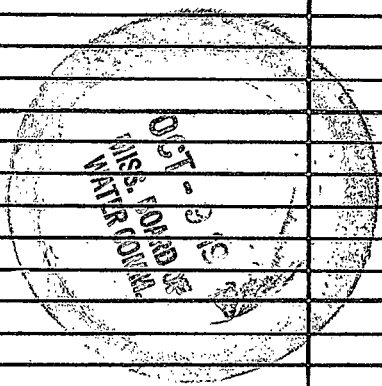

If well telescopes please sketch and show depths.

GROUND LEVEL

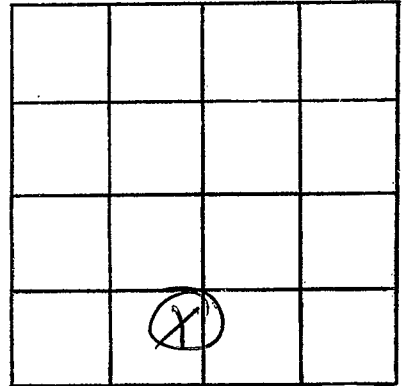

SECTION 33

Please indicate well location X.

ADDITIONAL INFORMATION

If more than one screen,
show locations of each on sketch.