

MISSISSIPPI
BOARD OF WATER COMMISSIONERS
416 North State Street
Jackson, Mississippi 39201

CODED

WATER WELL DRILLERS LOG

PERRY
F 15
70

date well completed 19 70 firm name S.R. county well located Rank

LANDOWNER Miss. Richter

description of formations encountered

from to
0 13
13 48

fine clay
fine

Pighton, Miss
(mailing address)

WELL LOCATION:

sec. 17 T 4 N S R 9 E
3 miles S of Pighton
(distance) (direction) (nearest town)

WELL PURPOSE: Home
(home, irrigation, municipal, industrial)

WELL COMPLETION DATA:

- (1) diameter (inches) 4
- (2) total depth (feet) 48
- (3) static water level (feet) 19 below above top of ground.
- (4) casing plastic, 43
(material) (depth)
- 4 if telescope see back.
(size)
- (5) screen 5, 43
(length) (depth to top)
- 4, plastic
(size) (material)
- (6) pump 1/2, 200 g.
(HP) (yield gpm)
- Suk
(type power)
- (7) electric log _____
(yes or no)

CODED

(organization running log)

(8) how well bottom plugged Value


OCT 12 1970

DRILLERS REMARKS:

MISS. BD. OF
WATER COMMISSIONERS

If well telescopes please sketch and show depths.

GROUND LEVEL

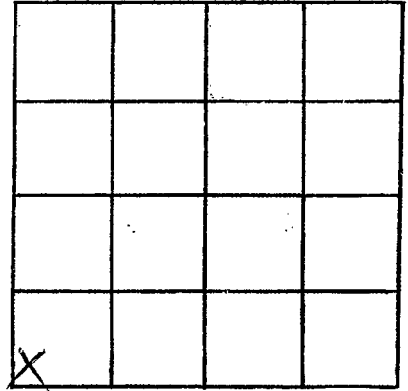

SECTION 17

Please indicate well location X.

ADDITIONAL INFORMATION

If more than one screen, show locations of each on sketch.