

PERRY  
F17  
9-6-72

MISSISSIPPI  
BOARD OF WATER COMMISSIONERS  
416 North State Street  
Jackson, Mississippi 39201

**CODED**

WATER WELL DRILLERS LOG

9-6-72 1972 Robertson S Perry  
date well completed firm name county well located

LANDOWNER: Mrs. Beulah Ford  
(mailing address)  
WELL LOCATION:  
sec. 31 T. 4 S. R. 9 E.  
miles of Antwerp  
(distance) (direction) (nearest town)

description of formations encountered	from	to
Clay	0	12
Clay	12	15
Sand	15	22
Sand	22	32
Sand	32	42
Sand	42	52
Sand	52	55
Clay	55	62
Clay	62	72
Clay	72	75
Sand	75	82
Sand	82	92
Sand	92	102
Sand	102	110

WELL PURPOSE:  
(home, irrigation, municipal, industrial)

WELL COMPLETION DATA:  
(1) diameter (inches) 2"  
(2) total depth (feet) 110  
(3) static water level (feet) 7.5 below top of ground.  
(4) casing PVC, 100, (material) (depth)  
2 (size) If telescope see back.  
(5) screen 10, 100 (length) (depth to top)  
2, PVC (size) (material)  
(6) pump 1, 340 gpm (HP) (yield gpm)  
Jet (type power)  
(7) electric log (yes or no)  
(organization running log)  
(8) how well bottom plugged none

**CODED**


SEP 28 1972

MISS. Bd. OF WATER COMM.

DRILLERS REMARKS:

If well telescopes please sketch and show depths.

GROUND LEVEL

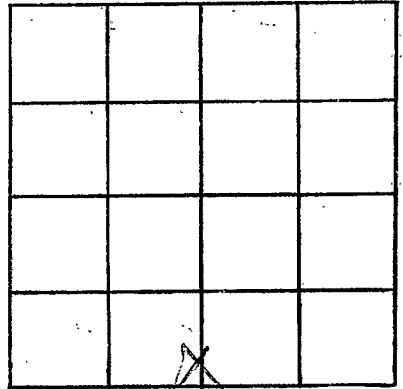

SECTION 31

Please indicate well location X.

ADDITIONAL INFORMATION

If more than one screen, show locations of each on sketch.