

Perry
 F19
 10-31-74

MISSISSIPPI
 BOARD OF WATER COMMISSIONERS
 416 North State Street
 Jackson, Mississippi 39201

CODED

WATER WELL DRILLERS LOG

10-31-74 date well completed
 J. J. Small Drilling firm name
 Perry county well located


LANDOWNER: Harrell Pinner
 R.F.D. 4
 Pickett miss (mailing address)

description of formations encountered	from	to
clay	0	15
gravel	15	22
hard sand	22	54
fine gravel & sand	54	87

WELL LOCATION:
 sec. 3 T. 4 N. R. 9 E. S. 1 W.
3.2 miles (distance) S (direction) Pickett (nearest town)

WELL PURPOSE: Home
 (home, irrigation, municipal, industrial)

- WELL COMPLETION DATA:
- (1) diameter (inches) 2"
 - (2) total depth (feet) 87 ft
 - (3) static water level (feet) 38 ft below/above top of ground
 - (4) casing plastic 4 1/2 ft (material) (depth)
2" (size) if telescope see back.
 - (5) screen 5 ft (length) 8 1/2 ft (depth to top)
2" (size) plastic (material)
 - (6) pump 1 (HP) 15 (yield gpm)
9 ft (type power)
 - (7) electric log ✓ (yes or no)
✓ (organization running log)
 - (8) how well bottom plugged valve

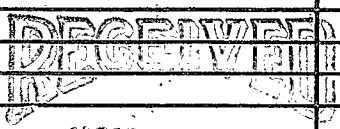


NOV 5 1974

DRILLERS REMARKS:

If well telescopes please sketch and show depths.

GROUND LEVEL

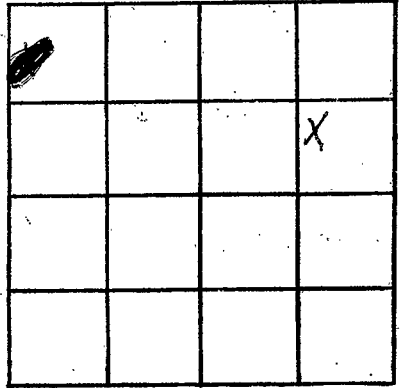

SECTION _____

Please indicate well location X.

ADDITIONAL INFORMATION

If more than one screen, show locations of each on sketch.