

Perry
F-22
1980

MISSISSIPPI
BOARD OF WATER COMMISSIONERS
416 North State Street
Jackson, Mississippi 39201

CODED

WATER WELL DRILLERS LOG

10 1980 date well completed
Roy V. West Drilling firm name
Perry county well located

LANDOWNER:	description of formations encountered	from	to
Perry County Landfill	CLAY SAND	0	90
		90	170

(mailing address)

WELL LOCATION:
sec. 24 T 4 N R 9 E S W
8 miles SE of Richton
(distance) (direction) (nearest town)

WELL PURPOSE:
(home, irrigation, municipal, industrial)

WELL COMPLETION DATA:

- (1) diameter (inches) 2"
- (2) total depth (feet) 170'
- (3) static water level (feet) 120' below top of ground.
- (4) casing PVC, 16.5' (material) (depth)
- (size) if telescope see back.
- (5) screen 5' length, 16.5' depth to top
- 1 1/2" stainless steel (size) (material)
- (6) pump 1/2 HP, 5 (yield gpm)
- REA (type power)
- (7) electric log NO (yes or no)
- (organization running log)
- (8) how well bottom plugged
WASH VALVE

DEPT. OF NATURAL RESOURCES
BUREAU OF LAND & WATER RESOURCES


SEP 11 1980

RECEIVED

DRILLERS REMARKS:

If well telescopes please sketch and show depths.

GROUND LEVEL

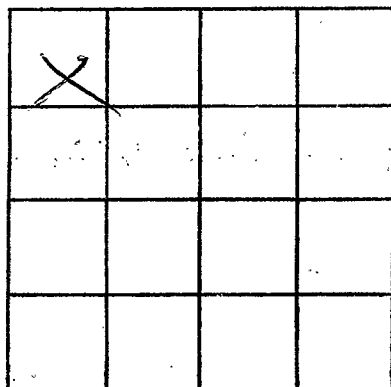

SECTION _____

Please indicate well location X.

ADDITIONAL INFORMATION

If more than one screen,
show locations of each on sketch.