

MISSISSIPPI DEPARTMENT OF NATURAL RESOURCES

Bureau of Land and Water Resources

Southport Mall

P.O. Box 10631

Jackson, Mississippi 39209

WATER WELL DRILLERS LOG

179
CODED

PERRY
S.F. 25

1/1 1987 Tom Griffith the weller Perry
date well completed firm name county well located

LANDOWNER: <u>David & New</u>	description of formations encountered	from	to
<u>PO Box 1487</u> <u>Natchez, Ms 39120</u> (mailing address)			
WELL LOCATION: 30 29 43 (N) R 9 (E) S sec. T S R E W	Sand	1	60
5 miles south of Richton (distance) (direction) (nearest town)	Clay	60	180
WELL PURPOSE: <u>for supply</u> (home, irrigation, municipal, industrial)	Sand	180	210
WELL COMPLETION DATA:	Clay	210	340
(1) diameter (inches) <u>3"</u>	Sand	340	370
(2) total depth (feet) <u>40</u>	Clay	370	400
(3) static water level (feet) <u>75</u> below top of ground.	Sand	400	440
(4) casing <u>PVC</u> , <u>400</u> , (material) (depth)			
<u>NA</u> if telescope see back. (size)			
(5) screen <u>40'</u> , <u>400</u> (length) (depth to top)			
<u>3"</u> , <u>PVC</u> (size) (material)			
(6) pump <u>airlift</u> , <u>75</u> (HP) (yield gpm)			
<u>diesel</u> (type power)			
(7) electric log <u>NO</u> (yes or no)			
<u>NA</u> (organization running log)			
(8) how well bottom plugged <u>BWC</u>			
DRILLERS REMARKS:			

CODED


RECEIVED

SEP 21 1987

Department of Natural Resources
Bureau of Land & Water Resources

If well telescopes please sketch and show depths.

GROUND LEVEL

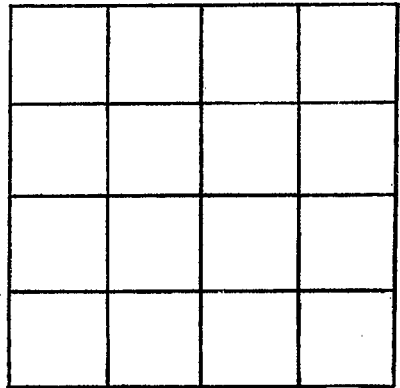

SECTION _____

Please indicate well location X.

ADDITIONAL INFORMATION

If more than one screen,
show locations of each on sketch.