

PERRY
 F 2000
 4-20-76

MISSISSIPPI
 BOARD OF WATER COMMISSIONERS
 416 North State Street
 Jackson, Mississippi 39201

WATER WELL DRILLERS LOG

April 20 1976 *Cochran Drilling Inc* Perry
 date well completed firm name county well located

LANDOWNER:
Jessie Hinton
Rt 5 Richton
 (mailing address)


description of formations encountered	from	to
<i>top soil</i>	<i>0</i>	<i>3</i>
<i>red clay</i>	<i>3</i>	<i>12</i>
<i>red sand</i>	<i>12</i>	<i>28</i>
<i>gray clay</i>	<i>28</i>	<i>42</i>
<i>sand</i>	<i>42</i>	<i>75</i>

WELL LOCATION:
 sec. *28* T *4* (N) R *9* E
2 miles *NE* of *Hentonsville*
 (distance) (direction) (nearest town)

WELL PURPOSE: *home*
 (home, irrigation, municipal, industrial)


- WELL COMPLETION DATA:
- (1) diameter (inches) 2"
 - (2) total depth (feet) 75'
 - (3) static water level (feet) 18' ^{below} _{above} top of ground.
 - (4) casing PVC, 70'
 (material) (depth)
2"
 (size) If telescope see back.
 - (5) screen 5', 70'
 (length) (depth to top)
2", PVC
 (size) (material)
 - (6) pump 1 6
 (HP) (yield gpm)
Elec
 (type power)
 - (7) electric log no
 (yes or no)
 (organization running log)
 - (8) how well bottom plugged Value

DRILLERS REMARKS:

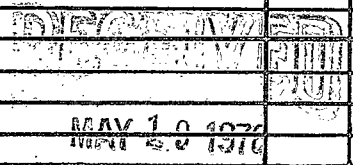

If well telescopes please sketch and show depths.

GROUND LEVEL

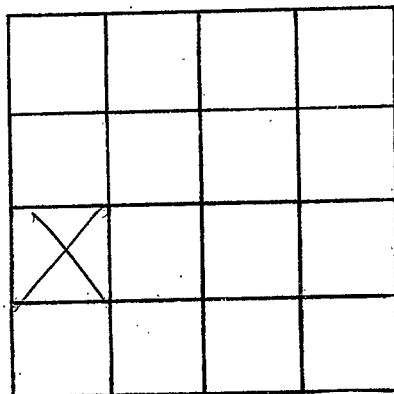

SECTION 28

Please indicate well location X.

ADDITIONAL INFORMATION

If more than one screen,
show locations of each on sketch.