

PERRY
 F 2001
 2-21-76

MISSISSIPPI
 BOARD OF WATER COMMISSIONERS
 416 North State Street
 Jackson, Mississippi 39201

WATER WELL DRILLERS LOG

Feb. 21 1976 *Cochran Drilling Co. Perry*
 date well completed firm name county well located

LANDOWNER:
Jimmy Pierce
Rt 3 Beaumont
 (mailing address)


WELL LOCATION:
 sec *36 T 4 N R 9 E*
6 miles *NE* of *Beaumont*
 (distance) (direction) (nearest town)

WELL PURPOSE: *none*
 (home, irrigation, municipal, industrial)

WELL COMPLETION DATA:
 (1) diameter (inches) *3"*
 (2) total depth (feet) *520'*
 (3) static water level (feet) _____ below/above top of ground.
 (4) casing *PVC 510'*
 (material) (depth)
 2"
 (size) If telescope see back.
 (5) screen *10' 510'*
 (length) (depth to top)
 2" PVC
 (size) (material)
 (6) pump _____ *40*
 (HP) (yield gpm)
 (type power)
 (7) electric log *no*
 (yes or no)
 (organization running log)
 (8) how well bottom plugged *Value*

description of formations encountered	from	to
<i>top soil</i>	<i>0</i>	<i>2</i>
<i>red sand</i>	<i>2</i>	<i>8</i>
<i>sand</i>	<i>8</i>	<i>26</i>
<i>whit. clay</i>	<i>26</i>	<i>31</i>
<i>brown clay</i>	<i>31</i>	<i>45</i>
<i>gray clay</i>	<i>45</i>	<i>63</i>
<i>shale clay</i>	<i>63</i>	<i>196</i>
<i>shale</i>	<i>196</i>	<i>231</i>
<i>blue clay</i>	<i>231</i>	<i>292</i>
<i>sand</i>	<i>292</i>	<i>307</i>
<i>blue clay</i>	<i>307</i>	<i>372</i>
<i>shale</i>	<i>372</i>	<i>391</i>
<i>sand</i>	<i>391</i>	<i>405</i>
<i>blue clay</i>	<i>405</i>	<i>468</i>
<i>sand</i>	<i>468</i>	<i>520</i>


DRILLERS REMARKS:

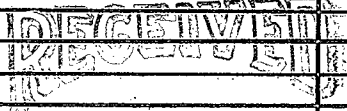

APR - 5 1976

If well telescopes please sketch and show depths.

GROUND LEVEL

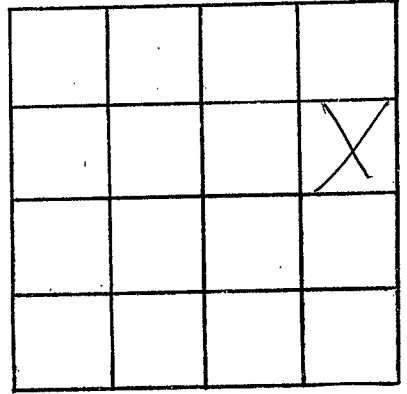

SECTION 36

Please indicate well location X.

ADDITIONAL INFORMATION

If more than one screen,
show locations of each on sketch.