

(Perry)
 264-3477
 F 2002
 10-9-79

MISSISSIPPI
 BOARD OF WATER COMMISSIONERS
 416 North State Street
 Jackson, Mississippi 39201
 WATER WELL DRILLERS LOG

10 - 09 - 19 79 Fryfogle Water Well Service Perry County
 date well completed firm name county well located

LANDOWNER: Leston Courtney	description of formations encountered	from	to
P.O. Box 201 New Augusta, Miss. (mailing address)			
	Water Sand	25	46
	Blue Clay	46	208
	Fine Sand gravel	208	210
	Loose Shell Clay	210	240
	Fine Sand & Clay	240	470
	Mud, Sand, Water	470	540
WELL LOCATION:			
sec. 17 T 4 N R 9 E S W			
10 miles North of Beamont (distance) (direction) (nearest town)			
WELL PURPOSE: (home, irrigation, municipal, industrial)			
WELL COMPLETION DATA:			
(1) diameter (inches) 2			
(2) total depth (feet) 515			
(3) static water level (feet) 10' below top of ground.			
(4) casing PVC, 500' (material) (depth)			
2 (size) If telescope see back.			
(5) screen 15', 500' (length) (depth to top)			
2" P.V.C. (size) (material)			
(6) pump 1/2 HP, 600 (yield gpm)			
Jet Shallow Well (type power)			
(7) electric log (yes or no)			
Over flow (organization running log)			
(8) how well bottom plugged back wash valve P.V.C.			

DRILLERS REMARKS: This well free flows 400 gallons per hour. no pump. Artisan, Extra Good Well


DEPT. OF NATURAL RESOURCES
 BUREAU OF LAND & WATER RESOURCES

DEC - 3 1979

RECEIVED

If well telescopes please sketch and show depths.

GROUND LEVEL

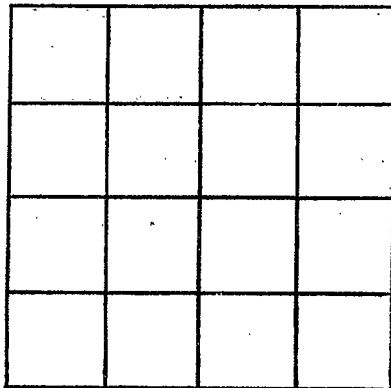

SECTION _____

Please indicate well location X.

ADDITIONAL INFORMATION

If more than one screen, show locations of each on sketch.