

Perry  
F 2003  
8-13-79

MISSISSIPPI  
BOARD OF WATER COMMISSIONERS  
416 North State Street  
Jackson, Mississippi 39201

WATER WELL DRILLERS LOG

Aug 13 1979 Porter Drilling Perry  
date well completed firm name county well located

LANDOWNER: Edward Johnson  
90 Otha Sellers  
At 4 Buckton Miss.  
(mailing address)

description of formations encountered	from	to
Clay	0	10
sand	10	17
Clay	17	155
Clay & some sand	155	162
med. fine sand	162	180
med. coarse sand	180	191
stratified clay		

WELL LOCATION:  
sec. 1 T 4 N R 9 E  
5 miles E Buckton  
(distance) (direction) (nearest town)

WELL PURPOSE: home  
(home, irrigation, municipal, industrial)

- WELL COMPLETION DATA:
- (1) diameter (inches) 2"
  - (2) total depth (feet) 191'
  - (3) static water level (feet) 91' <sup>below</sup> <sub>above</sub> top of ground.
  - (4) casing PVC 186'  
(material) (depth)  
2" if telescope see back.  
(size)
  - (5) screen 5' 186'  
(length) (depth to top)  
2" stainless S.S.  
(size) (material)
  - (6) pump 1/2 12  
(HP) (yield gpm)  
elec.  
(type power)
  - (7) electric log no  
(yes or no)  
  
(organization running log)
  - (8) how well bottom plugged 2" sand slash

no drop pipe

Miss. Board of Water Comm.


SEP 10 1979

DRILLERS REMARKS:  
shell top

RECEIVED

If well telescopes please sketch and show depths.

GROUND LEVEL

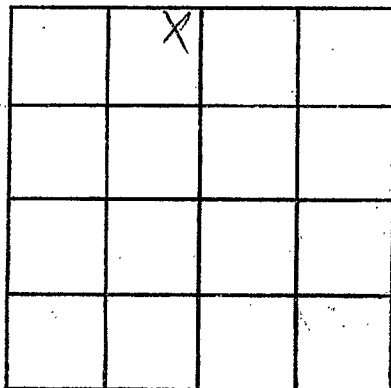

SECTION 1

Please indicate well location X.

ADDITIONAL INFORMATION

If more than one screen, show locations of each on sketch.