

MISSISSIPPI DEPARTMENT OF NATURAL RESOURCES

Bureau of Land and Water Resources

Southport Mall

P.O. Box 10631

Jackson, Mississippi 39209

WATER WELL DRILLERS LOG

PERRY
F 2004
5/23/81

May 23 19 81 Cochran Brothers Drilling PERRY
date well completed firm name county well located

LANDOWNER:	description of formations encountered	from	to
MRS. Betsie Roberts			
Rt 4 <u>Beaumont</u> (mailing address)	Fine sand clay	2	8
	gray clay	8	18
	sand	18	35
	gray clay	35	42
	sand	42	80

WELL LOCATION:
sec. 3 T. 4 N. R. 9 E.
2 miles South of Hintonville
(distance) (direction) (nearest town)

WELL PURPOSE: home
(home, irrigation, municipal, industrial)

- WELL COMPLETION DATA:
- (1) diameter (inches) 2"
 - (2) total depth (feet) 80'
 - (3) static water level (feet) 15' below top of ground.
 - (4) casing PVC 75'
(material) (depth)
if telescope see back, (size)
 - (5) screen 5' 75'
(length) (depth to top)
2" PVC
(size) (material)
 - (6) pump 1 8
(HP) (yield gpm)
elec
(type power)
 - (7) electric log no
(yes or no)
(organization running log)
 - (8) how well bottom plugged value

DRILLERS REMARKS:


DEPT. OF NATURAL RESOURCES
BUREAU OF LAND & WATER RESOURCES

JUN 17 1981

RECEIVED

If well telescopes please sketch and show depths.

GROUND LEVEL

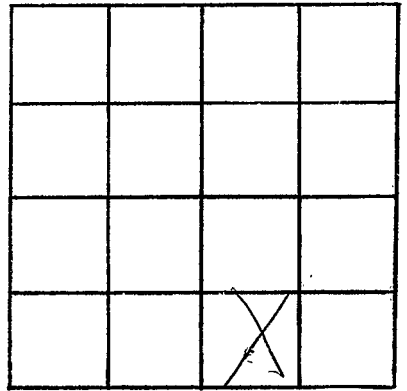

SECTION 5

Please indicate well location X.

ADDITIONAL INFORMATION

If more than one screen, show locations of each on sketch.