

MISSISSIPPI DEPARTMENT OF NATURAL RESOURCES

Bureau of Land and Water Resources

Southport Mall

P.O. Box 10631

Jackson, Mississippi 39209

WATER WELL DRILLERS LOG

Perry  
F 2005  
9-5-81

Sept 5 1981 date well completed

Cochran Drilling firm name

Perry county well located

| LANDOWNER:  | description of formations encountered | from       | to         |
|---|---------------------------------------|------------|------------|
|   |                                       |            |            |
| Laniel PARKER   | Top soil                              | 0          | 2          |
| Rt. 1 Beaumont<br>(mailing address)                       | Red clay                              | 2          | 7          |
|   | Red sand                              | 7          | 12         |
| WELL LOCATION: ?  | Sand                                  | 12         | 18         |
|   | Gray clay                             | 18         | 25         |
| sec. <u>36</u> T. <u>4</u> N. R. <u>9</u> E. <u>W</u>     | Blue clay                             | <u>25</u>  | <u>120</u> |
| <u>7</u> miles <u>N.E.</u> of <u>Beaumont</u>             | Sand                                  | <u>120</u> | <u>135</u> |
| (distance) (direction) (nearest town)                     | Blue clay                             | <u>135</u> | <u>190</u> |
| WELL PURPOSE: <u>Home</u>                                 | Sand                                  | <u>190</u> | <u>210</u> |
| (home, irrigation, municipal, industrial)                 | Blue clay                             | <u>210</u> | <u>360</u> |
| WELL COMPLETION DATA:                                     | Blue sand                             | <u>360</u> | <u>375</u> |
| (1) diameter (inches) <u>2"</u>                           | Blue clay                             | <u>375</u> | <u>40</u>  |
| (2) total depth (feet) <u>550'</u>                        | Sand                                  | <u>40</u>  | <u>435</u> |
| (3) static water level (feet) <u>below</u> top of ground. | Blue clay                             | <u>435</u> | <u>478</u> |
| (4) casing <u>PVC 540'</u> (material) (depth)             | Sand                                  | <u>478</u> | <u>550</u> |
| (size) If telescope see back.                             |                                       |            |            |
| (5) screen <u>10' 540'</u> (length) (depth to top)        |                                       |            |            |
| (size) (material) <u>2" PVC</u>                           |                                       |            |            |
| (6) pump (HP) (yield gpm)                                 |                                       |            |            |
| (type power)  |                                       |            |            |
| (7) electric log (yes or no)                              |                                       |            |            |
| (organization running log)                                |                                       |            |            |
| (8) how well bottom plugged <u>value</u>                  |                                       |            |            |
| DRILLERS REMARKS:   |                                       |            |            |


DEPT. OF NATURAL RESOURCES  
 BUREAU OF LAND & WATER RESOURCES

OCT 19 1981

RECEIVED

If well telescopes please sketch and show depths.

GROUND LEVEL

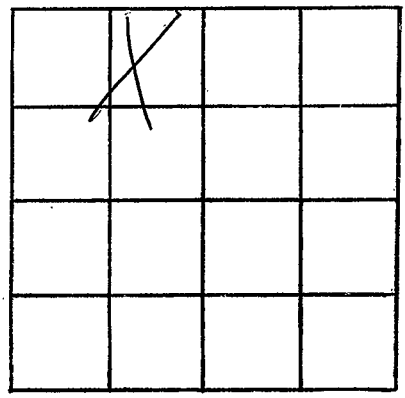

SECTION 36

Please indicate well location X.

ADDITIONAL INFORMATION

If more than one screen, show locations of each on sketch.