




If well telescopes please  
sketch and show depths.

GROUND LEVEL

RECEIVED  
81 OCT 16 4 9: 07

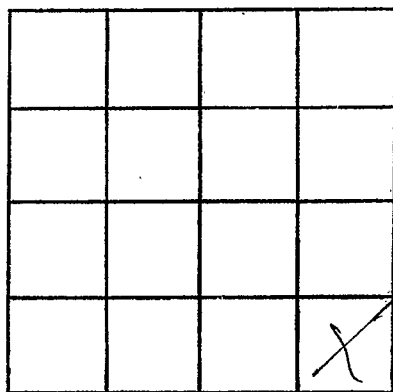

SECTION 36

Please indicate well location X.

ADDITIONAL INFORMATION

If more than one screen,  
show locations of each on sketch.