

MISSISSIPPI DEPARTMENT OF NATURAL RESOURCES
Bureau of Land and Water Resources
 Southport Mall
 P.O. Box 10631
 Jackson, Mississippi 39209
WATER WELL DRILLERS LOG

Perry
F
2007

Oct 1982 date well completed Cochran Brother's Drilling Service firm name Perry county well located

LANDOWNER: <u>Jimmy Hinton</u> <u>Rt. 1</u>	description of formations encountered	from	to
<u>Beaumont</u> (mailing address)	<u>TOP Soil</u>	<u>0</u>	<u>2</u>
	<u>Red clay</u>	<u>2</u>	<u>8</u>
	<u>BRAY CLAY</u>	<u>8</u>	<u>21</u>
	<u>sand</u>	<u>21</u>	<u>58</u>
WELL LOCATION: sec. <u>28</u> T <u>4</u> (N) S R <u>9</u> (E) W <u>4</u> miles <u>E</u> of <u>Hintonville</u> (distance) (direction) (nearest town)			
WELL PURPOSE: <u>none</u> (home) irrigation, municipal, industrial			
WELL COMPLETION DATA:			
(1) diameter (inches) <u>2"</u>			
(2) total depth (feet) <u>58'</u>			
(3) static water level (feet) <u>19</u> <u>below</u> above top of ground.			
(4) casing <u>PVC</u> , <u>53'</u> (material) (depth)			
_____ if telescope see back. (size)			
(5) screen <u>5'</u> , <u>53'</u> (length) (depth to top)			
<u>2"</u> , <u>PVC</u> (size) (material)			
(6) pump <u>1</u> , <u>1</u> (HP) (yield gpm)			
<u>Elec.</u> (type power)			
(7) electric log <u>no</u> (yes or no)			
_____ (organization running log)			
(8) how well bottom plugged <u>valve</u>			

DEPT. OF NATURAL RESOURCES
 BUREAU OF LAND & WATER RESOURCES


FEB 16 1983

RECEIVED

DRILLERS REMARKS: _____

If well telescopes please sketch and show depths.

GROUND LEVEL

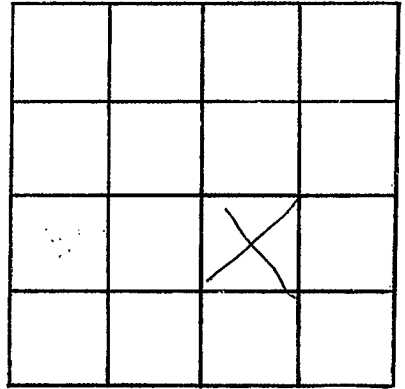

SECTION 28

Please indicate well location X.

ADDITIONAL INFORMATION

If more than one screen,
show locations of each on sketch.