

Perry
F 2009

MISSISSIPPI
BOARD OF WATER COMMISSIONERS
416 North State Street
Jackson, Mississippi 39201

WATER WELL DRILLERS LOG

Feb 2 1982 Roy V. West Drly Inc Perry
date well completed firm name county well located

| LANDOWNER: | description of formations encountered | from | to |
|---|---------------------------------------|------|-----|
| Henry Stevens Farm | | | |
| P.O. Box 528 Richton (mailing address) | SAND | 12 | 48 |
| | CLAY | 48 | 53 |
| | SAND | 53 | 153 |

WELL LOCATION:
sec. 18 T 4 N R 9 E
S W
3 miles S of Richton
(distance) (direction) (nearest town)

WELL PURPOSE: WATER CATTLE
(home, irrigation, municipal, industrial)

- WELL COMPLETION DATA:
- (1) diameter (inches) 4"
 - (2) total depth (feet) 153'
 - (3) static water level (feet) 98' below top of ground.
 - (4) casing PVC 143' (material) (depth)
 - (size) If telescope see back.
 - (5) screen 10" 143' (length) (depth to top)
 - 4" PVC (size) (material)
 - (6) pump 1/2 15 (HP) (yield gpm)
 - REA (type power)
 - (7) electric log NO (yes or no)
 - (organization running log)
 - (8) how well bottom plugged: WASH VALVE

DRILLERS REMARKS:


DEPT. OF NATURAL RESOURCES
BUREAU OF LAND & WATER RESOURCES

FEB 10 1982

RECEIVED

If well telescopes please sketch and show depths.

GROUND LEVEL

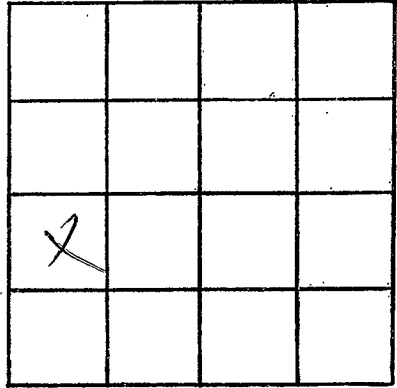

SECTION 18

Please indicate well location X.

ADDITIONAL INFORMATION

If more than one screen, show locations of each on sketch.