

F2014

MISSISSIPPI DEPARTMENT OF NATURAL RESOURCES

Bureau of Land and Water Resources

COUNTY WELL LOCATED
 Perry
 WELL NUMBER CODED
 7 E
 DATE WELL COMPLETED
 9/28/92

PERMIT NUMBER
 0-479
 NAME OF DRILLING FIRM
 Doherty Drilling
 Box 2311 Laurel MS

P.O. Box 10631
 Jackson, Mississippi 39209
 WATER WELL DRILLERS LOG

NAME & MAILING ADDRESS OF LANDOWNER
 Jason Rahain
 Wingate Road
 Richton Miss 39476
 WELL LOCATION: SEC TOWNSHIP RANGE
 18 4 N 9 E W
 DISTANCE DIRECTION NEAREST TOWN
 10 Miles S.W. of Richton
 OTHER LANDMARK
 WELL PURPOSE: Home, Irrigation, Municipal, Industrial, Fish Pond, etc.
 Home

PUMP DATA
 PUMP TYPE (Circle One):
 Submersible, Turbine, Jet, Flowing Well,
 Other (Describe)
 POWER TYPE (Circle One):
 Electric, Tractor, Diesel, Gasoline, Butane,
 Other (Describe)
 Pump Capacity (GPM) No. of Stages Setting Depth
 8 9 115 FT.
 PUMP TEST
 Well yielded 8 GPM with
 a drawdown of _____ ft.
 after _____ hours of pumping

WELL DATA
 Well Depth Casing Diameter (In.) Casing Length (Ft.)
 130 4" 130
 Type of Casing Hole Depth Depth to Static Water Level
 PVC 130 95
 TYPE OF COMPLETION: (Circle One or More):
 Gravel Packed, Underreamed, Telescoped,
 Natural Development, Open Hole, Other
 (Describe)
 Top of Lap Pipe or Reduction in Casing
 FEET IF TELESKOPED OR MORE THAN ONE SCREEN: USE BACK PAGE

LOG DATA
 TYPE OF LOG RUN (Circle One): No Log Run,
 Electric, Gamma Ray, Density, Sonic, Neutron,
 Other (Describe)
 Name of Organization Running Log

SCREEN DATA
 Diameter - Inches Length - Feet Slot Size - Inches
 4 10ft .012
 Screen Type Depth to Bottom - Feet
 PVC 4" casing 130ft

GEOLOGIC DATA (Office Use Only)

Surface Elev.	Geologic Unit	Unit Thickness	Depth to Top
Subs. SWL	Date	Analysis	Aquifer Test

 Driller's Remarks

DESCRIPTION OF FORMATIONS ENCOUNTERED	FROM	TO
0 to 45 Brown clay	0	45
white clay	45	50
Blue clay	50	92
water gravel or coarse sand	92	130

FORMATIONS (Continued)

FROM	TO


OCT 30 1992

Dept. of Environmental Quality
 Bureau of Land & Water Resources

IF MORE SPACE IS NEEDED, USE BACK

If well telescopes please
sketch and show depths.

GROUND LEVEL

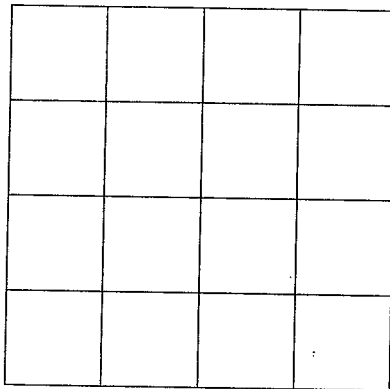

SECTION _____

Please indicate well location X.

ADDITIONAL INFORMATION

If more than one screen,
show location of each on sketch.