

PERRY
G9

CODED

WATER WELL DRILLERS LOG

Date: 6-13, 1961, Driller: David Newell County Perry
354 370 377 378 380 (Name)

(1) Owner of Land: J. J. Wilson
(Name)
New Augusta, Miss
(Address)
(2) Location: With field 33 S 11 W
7 miles West of New Augusta
(distance) (direction) (Nearest Town)
(3) Topography: Hilly
(Hilly) (Flat) (Level)
(4) Purpose of Well: Domestic
(Domestic Irrigation
Municipal, Industrial, Other)

Description & Color of Materials Sand, Clay, Red Clay, Shell, etc.	Thick- ness Feet	Depth Feet
Sand		20
Sand & water		30
Chalk Clay		400
Sand		50


CODED

Information upon completion of well:

(1) Diameter 2 inches.
(2) Total Depth 500 feet.
(3) Water Level Flow feet below top of ground.
(4) Cased to 9", Size 2"
(5) Screen: Size 2", Length 10'
(6) Were any formations sealed against pollution?
_____ yes, X no.

If YES depth of formation _____
Why _____

Drillers Remarks: _____

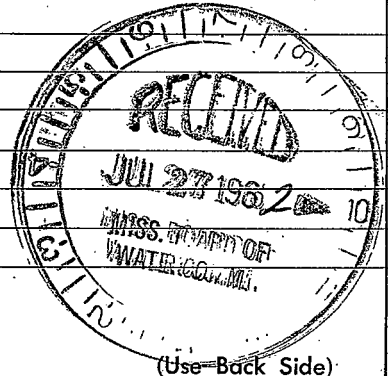

Well No.

