

CODED

MISSISSIPPI
BOARD OF WATER COMMISSIONERS
416 North State Street
Jackson, Mississippi 39201

WATER WELL DRILLERS LOG

Perry Co
G 10
T-69

7/29 1969 STR Perry
date well completed firm name county well located


| LANDOWNER | description of formations encountered | from | to |
|---|---------------------------------------|------|----|
| PT 3 | clay | 0 | 10 |
| Richley, Miss. (mailing address) | fine sand | 10 | 30 |
| | gravelly clay | 30 | 60 |
| | sand + silt | 60 | 70 |
| | pt of sand | 70 | 85 |
| WELL LOCATION: | | | |
| sect 10 T 30 N R 11 E | | | |
| 4 miles N.W. of Mar. Forest | | | |
| (distance) (direction) (nearest town) | | | |
| WELL PURPOSE: Home | | | |
| (home, irrigation, municipal, industrial) | | | |
| WELL COMPLETION DATA: | | | |
| (1) diameter (inches) 2" | | | |
| (2) total depth (feet) 85 | | | |
| (3) static water level (feet) 21 37 below top of ground. | | | |
| (4) casing (material) plates (depth) 80 | | | |
| 2" (size) if telescope see back. | | | |
| (5) screen (length) 5 (depth to top) 80 | | | |
| 2" (size) plates (material) | | | |
| (6) pump 1 (HP) 1100 (yield gpm) | | | |
| jet (type power) | | | |
| (7) electric log (yes or no) | | | |
| (organization running log) | | | |
| (8) how well bottom plugged Valve | | | |
| DRILLERS REMARKS: | | | |

AUG 14 1969

MISS. BD. OF
WATER COMMISSIONERS

If well telescopes please sketch and show depths.

GROUND LEVEL

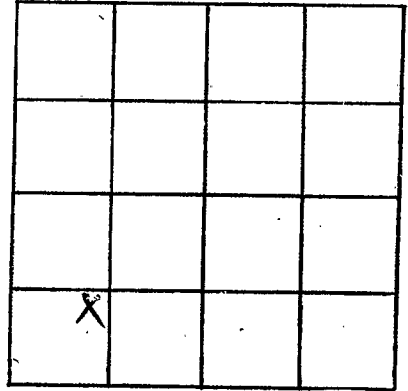

SECTION 10

Please indicate well location X.

ADDITIONAL INFORMATION

If more than one screen,
show locations of each on sketch.