

Perry
G 13
6-12-73

MISSISSIPPI
BOARD OF WATER COMMISSIONERS
416 North State Street
Jackson, Mississippi 39201

CODED

WATER WELL DRILLERS LOG

6-12-1973 date well completed
General Drilling Service firm name
Perry county well located

LANDOWNER: Frank Webb

description of formations encountered

Box 112
Bickleton miss
(mailing address)

from 0 to 11

WELL LOCATION:

clay
red fine sand 11 18

sec. 1 T. 3 (N) R. 11 E
12 miles S. of Hindsburg
(distance) (direction) (nearest town)

clean sand & gravel 18 22

WELL PURPOSE: Home
(home, irrigation, municipal, industrial)

WELL COMPLETION DATA:

(1) diameter (inches) 2"

(2) total depth (feet) 22 ft

(3) static water level (feet) 10 ft below top of ground.

(4) casing Plastic 17 ft (material) (depth)
2" (size) if telescope see back.

(5) screen 5 ft 22 ft (length) (depth to top)

2" Plastic (size) (material)

(6) pump 1 HP 750 gpm (HP) (yield gpm)
PSC (type power)

(7) electric log (yes or no)

(organization running log)

(8) how well bottom plugged valve

CODED


DRILLERS REMARKS:

AUG 1 1973

MISC. DI
WATER

If well telescopes please sketch and show depths.

GROUND LEVEL

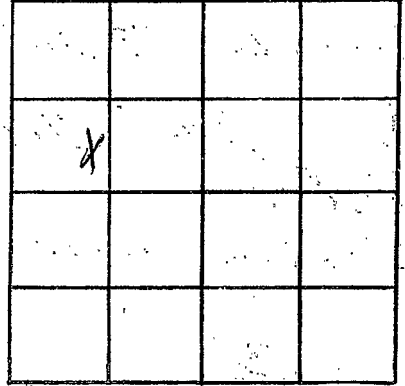

SECTION _____

Please indicate well location X.

ADDITIONAL INFORMATION

If more than one screen,
show locations of each on sketch.