

Perry
 614
 9-23-73

MISSISSIPPI
 BOARD OF WATER COMMISSIONERS
 416 North State Street
 Jackson, Mississippi 39201

CODED

WATER WELL DRILLERS LOG

Sept. 23 1973 Cochran Drillers Perry
 date well completed firm name county well located

LANDOWNER:
Earnest L. McArdle
 (mailing address)

WELL LOCATION:
 sec 22 T 3 N 11 E
3 miles West of New Augusta
 (distance) (direction) (nearest town)

WELL PURPOSE: home
 (home, irrigation, municipal, industrial)

WELL COMPLETION DATA:

(1) diameter (inches) 2"

(2) total depth (feet) 55'

(3) static water level (feet) 8 below above top of ground.

(4) casing PVC, 50'
 (material) (depth)
 If telescope see back.
 (size)

(5) screen 5', 50'
 (length) (depth to top)
2", PVC
 (size) (material)

(6) pump 1 6
 (HP) (yield gpm)
Elect
 (type power)

(7) electric log no
 (yes or no)
 (organization running log)

(8) how well bottom plugged valve

description of formations encountered	from	to
Top Soil	0	4
Red clay	4	6
Red clay	6	12
Brown clay	12	18
blue clay	18	31
sand	31	55


FREE

DRILLERS REMARKS:

NOV 5 1973

If well telescopes please sketch and show depths.

GROUND LEVEL

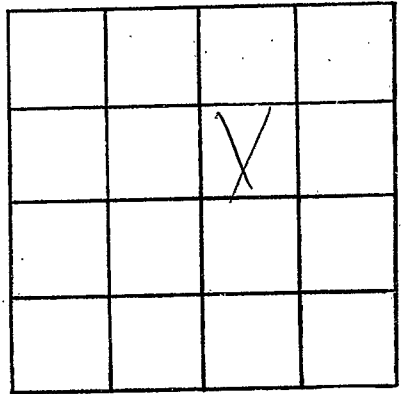

SECTION 22

Please indicate well location X.

ADDITIONAL INFORMATION

If more than one screen, show locations of each on sketch.