

PERRY
 6/6
 1-24-74

MISSISSIPPI
 BOARD OF WATER COMMISSIONERS
 416 North State Street
 Jackson, Mississippi 39201

WATER WELL DRILLERS LOG

Jan 24 1974 *Cashland Driller Perry*
 Date well completed firm name county well located

LANDOWNER:

Beil Carley

(mailing address)

WELL LOCATION:

sec. 5 T 3 N R 11 E
 S W

(distance) miles (direction) of (nearest town)

WELL PURPOSE: home
 (home, irrigation, municipal, industrial)

WELL COMPLETION DATA:

- (1) diameter (inches) 2"
- (2) total depth (feet) 100'
- (3) static water level (feet) 65' ^{below} above top of ground.
- (4) casing PVC, 95'
 (material) (depth)
2"
 (size) If telescope see back.
- (5) screen 5', 95'
 (length) (depth to top)
2", PVC
 (size) (material)
- (6) pump 1 6 1/2
 (HP) (yield gpm)
Elect
 (type power)
- (7) electric log no
 (yes or no)
 (organization running log)
- (8) how well bottom plugged Value

description of formations encountered


	from	to
<i>top soil</i>	<i>0</i>	<i>4</i>
<i>red clay</i>	<i>4</i>	<i>11</i>
<i>brown clay</i>	<i>11</i>	<i>39</i>
<i>gray clay</i>	<i>29</i>	<i>41</i>
<i>blue clay</i>	<i>41</i>	<i>82</i>
<i>Sandstone</i>	<i>82</i>	<i>100</i>

DRILLERS REMARKS:

RECORDED
 MAY 3 1974

If well telescopes please sketch and show depths.

GROUND LEVEL

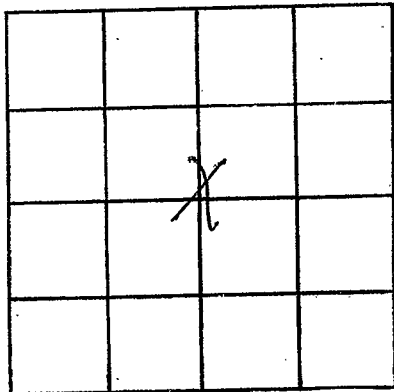

SECTION 5

Please indicate well location X.

ADDITIONAL INFORMATION

If more than one screen, show locations of each on sketch.