

Perry
G 18
9-4-74

MISSISSIPPI WATER WELL DRILLING
BOARD OF WATER COMMISSIONERS
416 North State Street
Jackson, Mississippi 39201
C. P. CLARK
ROUTE 2
LAUREL, MISS. 39440

WATER WELL DRILLERS LOG

9/4 1974 C.P. Clark Perry
date well completed firm name county well located

LANDOWNER: Bishop Griffin

description of formations encountered from to

RT#1
New Augusta
(mailing address)

Sandy Clay	0	12
Mixed Sand	12	20
Sand (poor)	20	39
Blue Clay	39	120
Mixed Color Clays	120	216
Sand (very fine)	216	227
Hard Clay	227	231

WELL LOCATION:
sec. 2 T. 3 (N) R. 11 E
3 1/2 miles SE of Rembertown
(distance) (direction) (nearest town)

WELL PURPOSE: Home
(home, irrigation, municipal, industrial)

WELL COMPLETION DATA:


- (1) diameter (inches) 2
- (2) total depth (feet) 227
- (3) static water level (feet) 48 below top of ground.
- (4) casing Galv Iron 216 (material) (depth)
- (size) If telescope see back.
- (5) screen 1 1/2 ft, 216 (length) (depth to top)
- 1 1/2 (size) SS Orange 90 (material)
- (6) pump 3/4 (HP) 6 (yield gpm)
- 1100 (type power)
- (7) electric log No (yes or no)
- (organization running log)
- (8) how well bottom plugged Bwu

DRILLERS REMARKS: Sit 7 AM
Get @ 8:45

RECEIVED
SEP - 9 1974

If well telescopes please sketch and show depths.

GROUND LEVEL

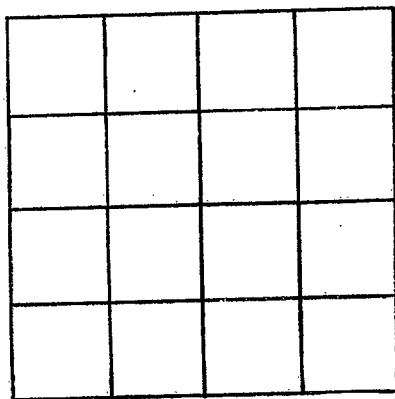

SECTION 2

Please indicate well location X.

ADDITIONAL INFORMATION

If more than one screen, show locations of each on sketch.