

Perry
 G 210
 7-15-75

MISSISSIPPI
 BOARD OF WATER COMMISSIONERS
 416 North State Street
 Jackson, Mississippi 39201

COPIED

WATER WELL DRILLERS LOG

July 15 1975 date well completed
 Cochran Drilling Service firm name
 Perry county well located

LANDOWNER: Jim Bowles
 Rt. 5
 New Augusta
 (mailing address)

WELL LOCATION:
 sec. 22 T. 3. N. R. 11 E. 13 Q.
 4 miles W of New Augusta
 (distance) (direction) (nearest town)

WELL PURPOSE: Home
 (home) irrigation, municipal, industrial

WELL COMPLETION DATA:
 (1) diameter (inches) 2"
 (2) total depth (feet) 535'
 (3) static water level (feet) below top of ground.
 (4) casing PVC 515' (material) (depth)
 (size) If telescope see back.
 (5) screen 20' 515' (length) (depth to top)
 2" PVC (size) (material)
 (6) pump (HP) 50 (yield gpm)
 (type power)
 (7) electric log (yes or no)
 (organization running log)
 (8) how well bottom plugged valve

description of formations encountered	from	to
Top soil	0	2
red clay	2	6
Brown clay	6	11
White clay	11	19
Red clay sand	19	24
sand + gravel	24	50
gray clay	50	83
Blue Clay	83	112
shale	112	138
Blue clay	138	164
sand	164	175
gray clay	175	193
crumbly shale	193	232
Blue clay	232	393
sand	393	418
Blue Clay	418	462
sand	462	535


COPIED

SEP - 2 1975
 MISS. Bd. OF WATER COMMISSIONERS

DRILLERS REMARKS:

If well telescopes please sketch and show depths.

GROUND LEVEL

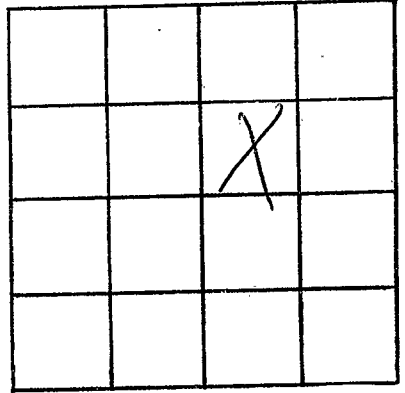

SECTION 22

Please indicate well location X.

ADDITIONAL INFORMATION

If more than one screen, show locations of each on sketch.