

Perry  
 9220  
 8-15-75

MISSISSIPPI  
 BOARD OF WATER COMMISSIONERS  
 416 North State Street  
 Jackson, Mississippi 39201

**CODED**

WATER WELL DRILLERS LOG

Aug 15 1975 Gehean Drilling Service Perry  
 date well completed firm name county well located

LANDOWNER: James Danner  
Routo 5  
New Augusta  
 (mailing address)

description of formations encountered	from	to
TOP soil	0	2
red clay	2	6
Brown clay	6	11
white clay	4	19
red sand	19	24
sand & gravel	24	50

WELL LOCATION:  
 sec 22 T 30 N R 11 13<sup>φ</sup>  
4 miles W of New Augusta  
 (distance) (direction) (nearest town)

WELL PURPOSE: Home  
 (home, irrigation, municipal, industrial)

- WELL COMPLETION DATA:
- diameter (inches) 8"
  - total depth (feet) 30'
  - static water level (feet) 10 below above top of ground.
  - casing PVC, 45'  
 (material) (depth)  
 (size) if telescope see back.
  - screen 5', 45"  
 (length) (depth to top)  
2", PVC  
 (size) (material)
  - pump 1, 6  
 (HP) (yield gpm)  
Elec  
 (type power)
  - electric log no  
 (yes or no)  
 (organization running log)
  - how well bottom plugged valve

**CODED**


**RECEIVED**

DRILLERS REMARKS:

SEP 2 1975  
 MISS. BD. OF WATER COMMISSIONERS

If well telescopes please sketch and show depths.

GROUND LEVEL

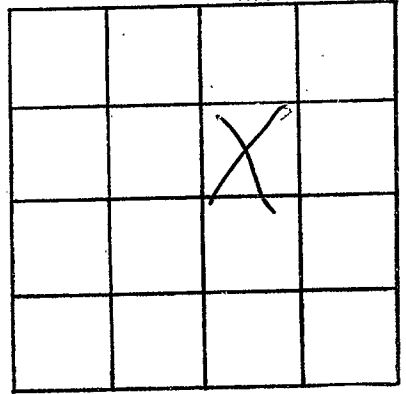

SECTION 22

Please indicate well location X.

ADDITIONAL INFORMATION

If more than one screen, show locations of each on sketch.