

PERRY  
G 23  
9-12-75

MISSISSIPPI  
BOARD OF WATER COMMISSIONERS  
416 North State Street  
Jackson, Mississippi 39201

WATER WELL DRILLERS LOG

*Perry*


*9-12-75* date well completed      *Swain Drill Co.* firm name      *Perry* county well located

LANDOWNER	description of formations encountered	from	to
<i>John Brangha</i>	<i>Clay</i>	<i>0</i>	<i>10</i>
<i>Ret. P.O.</i>	<i>P. S. &amp; S. S.</i>	<i>10</i>	<i>37</i>
<i>Rockton mixer</i> (mailing address)	<i>Clay</i>	<i>37</i>	<i>41</i>
WELL LOCATION: sec. <i>1</i> T. <i>3</i> N. <i>11</i> E. <i>13p</i> S. W.	<i>Clay</i>	<i>41</i>	<i>66</i>
<i>12</i> miles <i>S 12</i> of <i>Petal</i> (distance) (direction) (nearest town)	<i>P. S. &amp; S. S.</i>	<i>66</i>	<i>85</i>
WELL PURPOSE: <i>farm</i> (home, irrigation, municipal, industrial)			
WELL COMPLETION DATA:			
(1) diameter (inches) <i>2"</i>			
(2) total depth (feet) <i>85 ft</i>			
(3) static water level (feet) <i>26 ft</i> below top of ground			
(4) casing <i>plastic 80 ft</i> (material) (depth)			
<i>2"</i> If telescope see back. (size)			
(5) screen <i>5 ft</i> <i>85 ft</i> (length) (depth to top)			
<i>2"</i> <i>plastic</i> (size) (material)			
(6) pump <i>1</i> <i>8</i> (HP) (yield gpm)			
<i>2 hp</i> (type power)			
(7) electric log <i>e</i> (yes or no)			
<i>V</i> (organization running log)			
(8) how well bottom plugged <i>valve</i>			
DRILLERS REMARKS:			

RECEIVED  
OCT - 8 1975  
MISS. Bd. of W. Com.

If well telescopes please sketch and show depths.

GROUND LEVEL

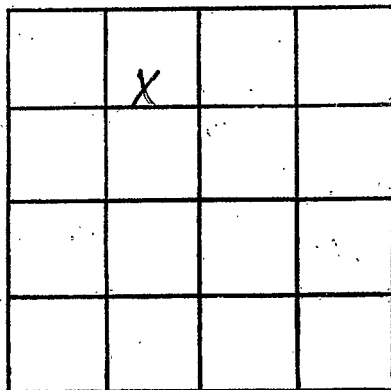

SECTION \_\_\_\_\_

Please indicate well location X.

ADDITIONAL INFORMATION

If more than one screen, show locations of each on sketch.