

CODED

Perry
 R24
 7-1-77
 E Log # 123
 7/1/77

MISSISSIPPI C. P. CLARK
 BOARD OF WATER COMMISSIONERS WELL DRILLING
 416 North State Street ROUTE 2
 Jackson, Mississippi 39201 LAUREL, MISS. 39440

WATER WELL DRILLERS LOG

C. P. Clark

Perry

date well completed 19 firm name county well located

LANDOWNER: W. C. Moody
 R#1
New Augusta Miss.
 (mailing address)

WELL LOCATION:
 sec. 23 T. 3N R. 11E
2 miles NW of Augusta
 (distance) (direction) (nearest town)

WELL PURPOSE: Home
 (home, irrigation, municipal, industrial)

WELL COMPLETION DATA:

(1) diameter (inches) 2

(2) total depth (feet) 508

(3) static water level (feet) +10 below above top of ground.

(4) casing Galv. Iron 498
 (material) (depth)

(size) If telescope see back.

(5) screen 10 498
 (length) (depth to top)
1/4" Solid S.S. 006
 (size) (material)

(6) pump None Flow 8 1/2 G.P.M.
 (HP) (yield gpm)

None
 (type power)

(7) electric log Yes
 (yes or no)
U.S. F.S.
 (organization running log)

(8) how well bottom plugged B.W.V.

description of formations encountered	from	to
Clay	0	14
Sand & Gravel	14	18
Clay	18	201
Clay (Chalky Strata)	207	270
Clay	270	296
Sand	296	298
Clay	299	405
Sandy Clay	405	415
Clay	415	447
Sand	447	530

CODED


RECEIVED
 AUG - 2 1977

MISS. BD. OF WATER COMM.

DRILLERS REMARKS: Customer to furnish own blow well flowed 510 L.P.H.

If well telescopes please sketch and show depths.

GROUND LEVEL

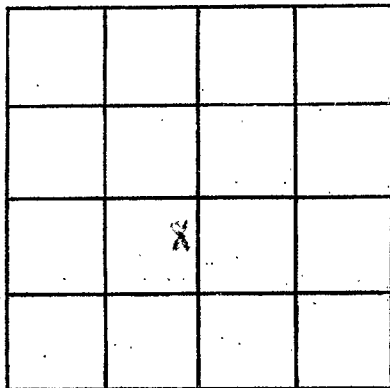

SECTION 23

Please indicate well location X.

ADDITIONAL INFORMATION

If more than one screen, show locations of each on sketch.