

Perry
 625
 3117178

MISSISSIPPI
 BOARD OF WATER COMMISSIONERS
 416 North State Street
 Jackson, Mississippi 39201

CODED

WATER WELL DRILLERS LOG

3/17/78
 date well completed


19 Given Drilling Service Perry
 firm name / county well located

LANDOWNER:	description of formations encountered	from	to
Tom Gordon	bravel & sand	0	12
Jones O'Brien	clay	12	155
L.C. Cox # 1	sand little pea bravel	155	231
(mailing address)	clay	231	252
WELL LOCATION:	sand & clay	252	294
sec. 19 T. 3 N. R. 11 E.	sand & pea bravel	294	372
1569 N + 1516 E 1/2 SW cor.	clay & sand	372	455
miles of (distance) (direction) of (nearest town)	sand & pea bravel	455	560
WELL PURPOSE:			
(home, irrigation, municipal, industrial)			
WELL COMPLETION DATA:			
(1) diameter (inches) 3"			
(2) total depth (feet) 560'			
(3) static water level (feet) 120' below top of ground.			
(4) casing steel 550' (material) (depth)			
3" (size) if telescope see back.			
(5) screen 42' 51-8 (length) (depth to top)			
3" perforated pipe (size) (material)			
(6) pump (HP) (yield gpm)			
AC (type power)			
(7) electric log NO (yes or no)			
(organization running log)			
(8) how well bottom plugged orange			
peel			
DRILLERS REMARKS:			

RECEIVED
 MAR 30 1978

If well telescopes please sketch and show depths.

GROUND LEVEL

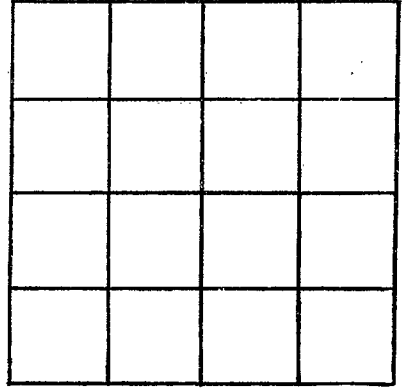

SECTION _____

Please indicate well location X.

ADDITIONAL INFORMATION

If more than one screen,
show locations of each on sketch.