

Perry  
 527  
 10/15/79  
 E Log #129

MISSISSIPPI  
 BOARD OF WATER COMMISSIONERS  
 416 North State Street  
 Jackson, Mississippi 39201

CODED

WATER WELL DRILLERS LOG

date well completed Oct 15 1979 firm name C. P. Clark Water Wells county well located Perry

LANDOWNER:	description of formations encountered	from	to
<u>Vittorio Houston</u>	<u>Sand</u>	<u>0</u>	<u>5</u>
<u>New Augusta, Miss</u>	<u>Clay</u>	<u>5</u>	<u>15</u>
(mailing address)	<u>Gravel</u>	<u>15</u>	<u>27</u>
WELL LOCATION:	<u>Blue green clay</u>	<u>27</u>	<u>195</u>
sec. <u>13</u> T. <u>3</u> N R. <u>11</u> E	<u>Sand</u>	<u>195</u>	<u>220</u>
<u>2</u> miles <u>NW</u> of <u>New Augusta</u>	<u>Clay</u>	<u>220</u>	<u>261</u>
(distance) (direction) (nearest town)	<u>Sand</u>	<u>261</u>	<u>274</u>
WELL PURPOSE: <u>home</u>	<u>Clay streaks</u>	<u>274</u>	<u>278</u>
(home, irrigation, municipal, industrial)	<u>Sand</u>	<u>278</u>	<u>303</u>
WELL COMPLETION DATA:	<u>Clay</u>	<u>303</u>	<u>317</u>
(1) diameter (inches) <u>2</u>	<u>Sand</u>	<u>317</u>	<u>318</u>
(2) total depth (feet) <u>628</u>	<u>Sandy clay</u>	<u>318</u>	<u>345</u>
(3) static water level (feet) <u>8 1/2</u> <sup>below</sup> top of ground.	<u>Clay w/ hard streaks</u>	<u>345</u>	<u>365</u>
(4) casing <u>Galv. St. 6 1/2'</u>	<u>Sand and clay streaks</u>	<u>365</u>	<u>505</u>
(material) (depth)	<u>Sand</u>	<u>505</u>	<u>510</u>
<u>2"</u> <del>1 1/2"</del> If telescope see back.	<u>Clay w/ sandy streaks</u>	<u>510</u>	<u>584</u>
(size)	<u>Sand</u>	<u>584</u>	<u>630</u>
(5) screen <u>15'</u> <u>6 1/2'</u>	<u>Clay w/ soft streaks</u>	<u>630</u>	<u>740</u>
(length) (depth to top)			
<u>1 1/4"</u> <u>Stainless Steel</u>			
(size) (material)			
(6) pump <u>none</u> <u>17 flow</u>			
(HP) (yield gpm)			
<u>none</u>			
(type power)			
(7) electric log <u>yes</u>			
(yes or no)			
<u>M. J. S.</u>			
(organization running log)			
(8) how well bottom plugged <u>BWV</u>			
DRILLERS REMARKS:			

CODED


DEPT. OF NATURAL RESOURCES  
 BUREAU OF LAND & WATER RESOURCES

OCT 25 1979

RECEIVED

If well telescopes please sketch and show depths.

GROUND LEVEL

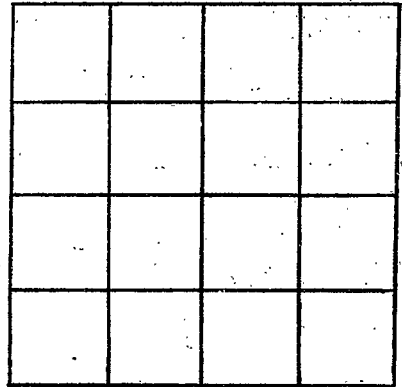

SECTION \_\_\_\_\_

Please indicate well location X.

ADDITIONAL INFORMATION

If more than one screen,  
show locations of each on sketch.