

Perry
 529
 10/31/79

MISSISSIPPI
 BOARD OF WATER COMMISSIONERS
 416 North State Street
 Jackson, Mississippi 39201

CODED

WATER WELL DRILLERS LOG

Oct. 3, 1979 19 date well completed
 C.P. Clark Water Wells Perry firm name
 county well located

LANDOWNER: New Augusta
Realy, Myr.
P.O. Box 358, New Augusta, Miss
 (mailing address)

description of formations encountered	from	to
Gravel & sand	0	20
Clay	20	65
Soft sand (?)	65	70
Clay	70	156
Sand	156	157
Hard Clay	157	206
Sand	206	241

WELL LOCATION:
 Sw¹⁴ sec. 13 T 3 N R 11 E
 1 1/2 miles NW of New Augusta
 (distance) (direction) (nearest town)

WELL PURPOSE: Industrial
 (home, irrigation, municipal, industrial)

- WELL COMPLETION DATA:
- (1) diameter (inches) 4
 - (2) total depth (feet) 241
 - (3) static water level (feet) 20 below top of ground.
 - (4) casing Galv. St. 231'
 (material) (depth)
4" If telescope see back.
 (size)
 - (5) screen 10' 231'
 (length) (depth to top)
4" Stainless Steel
 (size) (material) (code)
 - (6) pump 1 35 G. Gpsi
 (HP) (yield gpm)
220V 1Ø
 (type power)
 - (7) electric log no
 (yes or no)
 (organization running log)
 - (8) how well bottom plugged BWW

CODED


DEPT. OF NATURAL RESOURCES
 BUREAU OF LAND & WATER RESOURCES

OCT 25 1979
 RECEIVED

DRILLERS REMARKS:

If well telescopes please sketch and show depths.

GROUND LEVEL

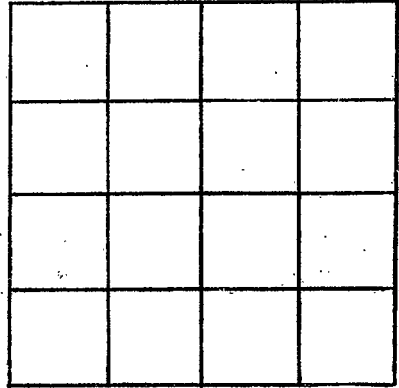

SECTION _____

Please indicate well location X.

ADDITIONAL INFORMATION

If more than one screen, show locations of each on sketch.