

PERRY  
G 30  
11-4-80

MISSISSIPPI DEPARTMENT OF NATURAL RESOURCES  
 Bureau of Land and Water Resources  
 Southport Mall  
 P.O. Box 10631  
 Jackson, Mississippi 39209  
**WATER WELL DRILLERS LOG**

**CODED**

NOVEMBER 4 1980 Cochran Brother Drilling Perry  
 date well completed firm name county well located

LANDOWNER: John Deakle  
Rt. 12  
Nattiesburg, Miss  
 (mailing address)

description of formations encountered	from	to
Top Soil	0	2
Red clay	2	6
red sand	6	14
sand + gravel	14	60

WELL LOCATION:  
 sec. 4 T 3 N R 11 E  
5 miles S of India Springs  
 (distance) (direction) (nearest town)

WELL PURPOSE: None  
 (home, irrigation, municipal, industrial)

WELL COMPLETION DATA:

- (1) diameter (inches) 4"
- (2) total depth (feet) 60'
- (3) static water level (feet) 18 below top of ground.
- (4) casing PVC 40'  
 (material) (depth)  
         if telescope see back.  
 (size)
- (5) screen 20' 40'  
4" (length) (depth to top)  
         (size) PVC (material)
- (6) pump 3/4 sub. 34  
 (HP) (yield gpm)  
Electric  
 (type power)
- (7) electric log NO  
 (yes or no)  
         (organization running log)
- (8) how well bottom plugged value

DRILLERS REMARKS:         


DEPT. OF NATURAL RESOURCES  
 BUREAU OF LAND & WATER RESOURCES

DEC - 4 1980

**RECEIVED**

If well telescopes please  
sketch and show depths.

GROUND LEVEL

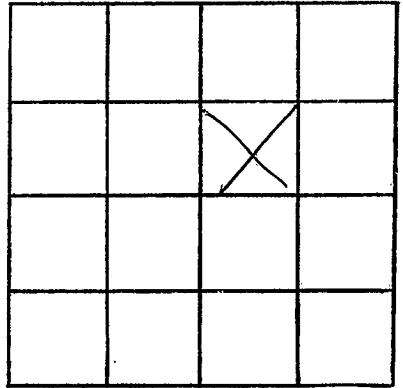

SECTION 4

Please indicate well location X.

ADDITIONAL INFORMATION

If more than one screen,  
show locations of each on sketch.