

MISSISSIPPI DEPARTMENT OF NATURAL RESOURCES

Bureau of Land and Water Resources


Southport Mall

P.O. Box 10631

Jackson, Mississippi 39209

WATER WELL DRILLERS LOG

CODED

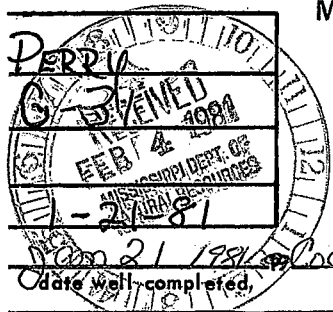

Date well completed, Jan 21 1981 firm name Rochean Brothers Drilling Service county well located PERRY

LANDOWNER: Willie Terby  
(mailing address)

description of formations encountered	from	to
Top Soil	0	2
Red clay	2	6
Red sand	6	12
White clay	12	18
sand & GRAVEL	18	50

WELL LOCATION:  
sec. 4 T 3 N R. 11 E  
7 miles SW of Indian Springs  
(distance) (direction) (nearest town)

WELL PURPOSE: home  
(home, irrigation, municipal, industrial)

- WELL COMPLETION DATA:
- (1) diameter (inches) 4"
  - (2) total depth (feet) 50'
  - (3) static water level (feet) 11 below above top of ground.
  - (4) casing PVC, 40'  
(material) (depth)
  - \_\_\_\_\_ if telescope see back.  
(size)
  - (5) screen 10' 40'  
4" (length) (depth to top)  
PVC  
(size) (material)
  - (6) pump 3/4 Sub, 33  
(HP) (yield gpm)  
Elec.  
(type power)
  - (7) electric log no  
(yes or no)  
(organization running log)
  - (8) how well bottom plugged VALVE

DRILLERS REMARKS: \_\_\_\_\_


DEPT. OF NATURAL RESOURCES  
BUREAU OF LAND & WATER RESOURCES

FEB 4 1981

RECEIVED

If well telescopes please sketch and show depths.

GROUND LEVEL

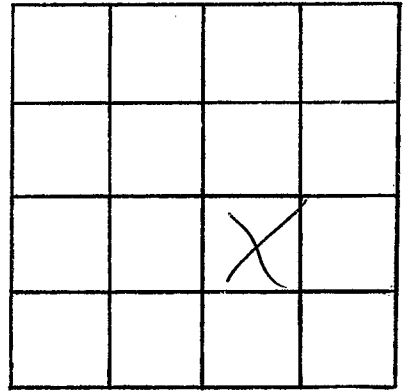

SECTION 4

Please indicate well location X.

ADDITIONAL INFORMATION

If more than one screen,  
show locations of each on sketch.