

Perry
 G32
 1/15/83
 Flag #

MISSISSIPPI
 BOARD OF WATER COMMISSIONERS
 416 North State Street
 Jackson, Mississippi 39201

CODED

WATER WELL DRILLERS LOG

1 515 1983 Ray V. West Waterwells Perry
 date well completed firm name county well located

LANDOWNER:	description of formations encountered	from	to
LEAF RIVER Forest Prod			
NEW Augusta MS (mailing address)	sand	5	35
	clay	35	160
	sandy silt	160	175
	Blue clay	175	445
	sand silt	445	450
	sand	450	498

WELL LOCATION:
 sec 7 T 3 N R 10 E
 3 miles N New Augusta
 (distance) (direction) (nearest town)

WELL PURPOSE:
 (home, irrigation, municipal, industrial)

WELL COMPLETION DATA:

(1) diameter (inches) 10 in

(2) total depth (feet) 498

(3) static water level (feet) 11 below above top of ground.

(4) casing Steel 452 (material) (depth)
 (size) If telescope see back.

(5) screen 40 458 (length) (depth to top)
 6 St steel (size) (material)

(6) pump 30 350 (HP) (yield gpm)
 R&A (type power)

(7) electric log yes (yes or no)
 Miss Leo Sway (organization running log)


(8) how well bottom plugged Washed

2

DEPT. OF NATURAL RESOURCES
 BUREAU OF LAND & WATER RESOURCES


AUG 21 1983

RECEIVED

DRILLERS REMARKS:


If well telescopes please sketch and show depths.

GROUND LEVEL

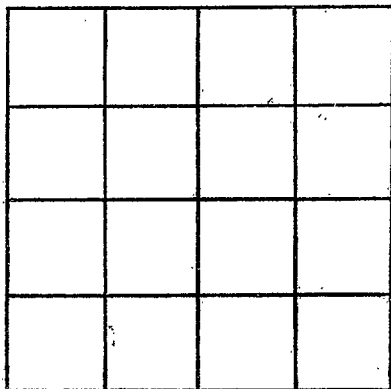

SECTION _____

Please indicate well location X.

ADDITIONAL INFORMATION

If more than one screen, show locations of each on sketch.