

MISSISSIPPI DEPARTMENT OF NATURAL RESOURCES
Bureau of Land and Water Resources
 Southport Mall
 P.O. Box 10631
 Jackson, Mississippi 39209
WATER WELL DRILLERS LOG

CODED

Perry
633

19 85 Roy K. WESTORLG Perry
 date well completed firm name county well located

LANDOWNER:
LEAF RIVER Forest Prod
New Augusta MS
 (mailing address)

description of formations encountered	from	to
<u>CLAY</u>	<u>0</u>	<u>8</u>
<u>SAND</u>	<u>8</u>	<u>39</u>
<u>CLAY</u>	<u>39</u>	<u>424</u>
<u>SAND</u>	<u>424</u>	<u>440</u>

WELL LOCATION:
 sec. 7 T. 3 N. R. 10 E. 11 W.
1 miles N of New Augusta
 (distance) (direction) (nearest town)

WELL PURPOSE: WASH & BACT
 (home, irrigation, municipal, industrial)

- WELL COMPLETION DATA:**
- diameter (inches) 4 1/2
 - total depth (feet) 440'
 - static water level (feet) 11' below above top of ground.
 - casing PVC, 425',
 (material) (depth)
 (size) if telescope see back.
 - screen 1/2", 425'
 (length) (depth to top)
4", PVC
 (size) (material)
 - pump 1, 27
 (HP) (yield gpm)
REA
 (type power)
 - electric log no
 (yes or no)
 (organization running log)
 - how well bottom plugged WASH VALVE

CODED


RECEIVED
 DEC 2 1985

Department of Natural Resources
 Bureau of Land & Water Resources

DRILLERS REMARKS:

If well telescopes please sketch and show depths.

GROUND LEVEL

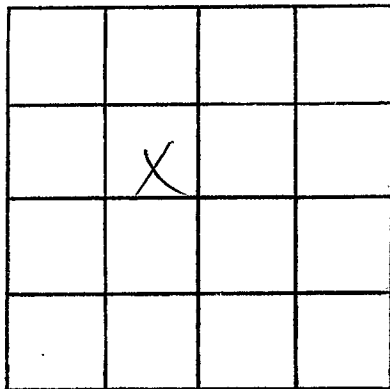

SECTION 7

Please indicate well location X.

ADDITIONAL INFORMATION

If more than one screen, show locations of each on sketch.