

PERRY
G 35

MISSISSIPPI DEPARTMENT OF NATURAL RESOURCES
Bureau of Land and Water Resources
Southport Mall
P.O. Box 10631
Jackson, Mississippi 39209
WATER WELL DRILLERS LOG

CODED

4-2 1985 Tom Griffith Well S/C Perry
date well completed firm name county well located

LANDOWNER: Glyn Roberts
P.O. Box 225
New Augusta, Ms 39462
(mailing address)

description of formations encountered	from	to
Chalk	0	17
Streaked	17	80
Hard Chalk	80	205
Good Sand	205	240

WELL LOCATION: S14 - T3N - R11W
sec. ~~24~~ ~~11~~ ~~11~~ N R E W
~~24~~ ~~11~~ ~~11~~ S W
1.5 miles N of New Augusta
(distance) (direction) (nearest town)

WELL PURPOSE: HOME
(home, irrigation, municipal, industrial)

WELL COMPLETION DATA:

- (1) diameter (inches) 4 1/2
- (2) total depth (feet) 240
- (3) static water level (feet) 30 below top of ground.
- (4) casing PVC, 220 (material) (depth)
N/A (size) if telescope see back.
- (5) screen 20 (length), 220 (depth to top), 010 (size), PVC FACTORY SHOP (material)
- (6) pump 3/4 (HP), 90 (yield gpm)
Elect. (type power)
- (7) electric log No (yes or no)
N/A (organization running log)
- (8) how well bottom plugged B/W

CODED


DIAGRAM
JUL 14 1986

DEPARTMENT OF NATURAL RESOURCES
Bureau of Land and Water Resources

DRILLERS REMARKS:

If well telescopes please sketch and show depths.

GROUND LEVEL

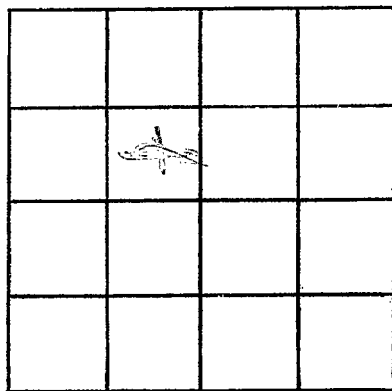

SECTION 14

Please indicate well location X.

ADDITIONAL INFORMATION

If more than one screen,
show locations of each on sketch.