

Perry
G 2000
10-28-76

MISSISSIPPI
 BOARD OF WATER COMMISSIONERS
 416 North State Street
 Jackson, Mississippi 39201

WATER WELL DRILLERS LOG

10-28 19 76 Perryman Well Drilling Co. Perry
 date well completed firm name county well located

LAND OWNERS	description of formations encountered	from	to
<u>W. H. D. J.</u>	<u>clay</u>	<u>0</u>	<u>10</u>
<u>Rickman miss.</u> (mailing address)	<u>Gravel to sand</u>	<u>10</u>	<u>25</u>
	<u>fine sand</u>	<u>29</u>	<u>32</u>
	<u>fine gravel to sand</u>	<u>32</u>	<u>62</u>

WELL LOCATION:

sec. 11 T. 3 N. R. 11 E.
10 miles S.W. of Rickman
 (distance) (direction) (nearest town)

WELL PURPOSE: none
 (home, irrigation, municipal, industrial)

WELL COMPLETION DATA:

- (1) diameter (inches) 2"
- (2) total depth (feet) 62 ft
- (3) static water level (feet) 20 below above top of ground.
- (4) casing Alumina, 57,
 (material) (depth)
2" If telescope see back.
 (size)
- (5) screen 5 ft, 62 ft
 (length) (depth to top)
2", Alastic
 (size) (material)
- (6) pump 1/2, 11
 (HP) (yield gpm)
jet
 (type power)
- (7) electric log (yes or no)
- (8) how well bottom plugged plugged


DRILLERS REMARKS:

RECEIVED

NOV 30 1976

If well telescopes please sketch and show depths.

GROUND LEVEL

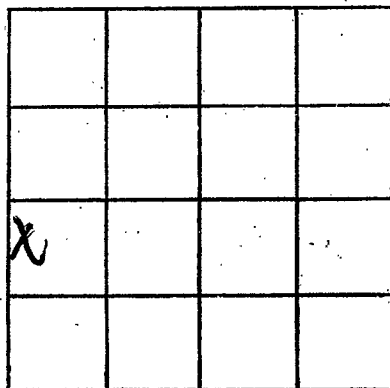

SECTION _____

Please indicate well location X.

ADDITIONAL INFORMATION

If more than one screen,
show locations of each on sketch.