

Perry
G 2002
11-3-76

MISSISSIPPI
 BOARD OF WATER COMMISSIONERS
 416 North State Street
 Jackson, Mississippi 39201

WATER WELL DRILLERS LOG

Nov 3 1976 Cochran Drilling Service Perry
 date well completed firm name county well located

LANDOWNER:
Billy Curry
 Rt 2 Hattiesburg
 (mailing address)

WELL LOCATION:
 sec. 7 T 3 N R 11 E
9 miles NW Paul August
 (distance) (direction) (nearest town)

WELL PURPOSE: Home
 (home, irrigation, municipal, industrial)

WELL COMPLETION DATA:

(1) diameter (inches) 4"

(2) total depth (feet) 85'

(3) static water level (feet) 42' below above top of ground.

(4) casing PVC 75'
 (material) (depth)

 if telescope see back.
 (size)

(5) screen 10' 75'
 (length) (depth to top)
4" PVC
 (size) (material)

(6) pump 1 22
 (HP) (yield gpm)
Elect
 (type power)

(7) electric log no
 (yes or no)

 (organization running log)

(8) how well bottom plugged Value

description of formations encountered	from	to
<u>top soil</u>	<u>0</u>	<u>2</u>
<u>red clay</u>	<u>2</u>	<u>8</u>
<u>red sand</u>	<u>8</u>	<u>19</u>
<u>white clay</u>	<u>19</u>	<u>27</u>
<u>brown clay</u>	<u>27</u>	<u>36</u>
<u>gray clay</u>	<u>36</u>	<u>51</u>
<u>sand & gravel</u>	<u>51</u>	<u>85</u>


RECEIVED

DEC 3 1976

DRILLERS REMARKS:

If well telescopes please sketch and show depths.

GROUND LEVEL

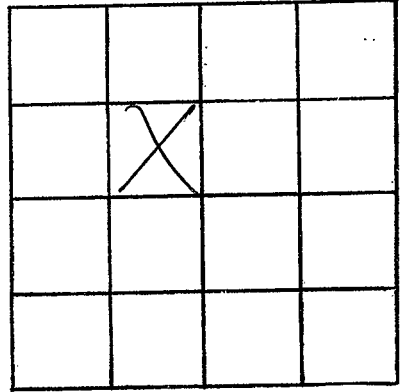

SECTION 7

Please indicate well location X.

ADDITIONAL INFORMATION

If more than one screen,
show locations of each on sketch.