

Perry  
G 2003  
11-22-76

MISSISSIPPI  
 BOARD OF WATER COMMISSIONERS  
 416 North State Street  
 Jackson, Mississippi 39201

WATER WELL DRILLERS LOG

Nov 22 1976 Cochran Drilling Inc Perry  
 date well completed firm name county well located

LANDOWNER:  
Sonnie Bibens  
Rt 2 New Augusta  
 (mailing address)

description of formations encountered	from	to
<u>top soil</u>	<u>0</u>	<u>2</u>
<u>red sand</u>	<u>2</u>	<u>9</u>
<u>brown clay</u>	<u>9</u>	<u>14</u>
<u>gray clay</u>	<u>14</u>	<u>29</u>
<u>sand</u>	<u>29</u>	<u>45</u>

WELL LOCATION:  
 sec. 8 T. 3 (N) S. R. 11 E. W.  
7 miles N.W. of New Augusta  
 (distance) (direction) (nearest town)

WELL PURPOSE: home  
 (home, irrigation, municipal, industrial)

WELL COMPLETION DATA:

(1) diameter (inches) 2"

(2) total depth (feet) 45'

(3) static water level (feet) 18' below above top of ground.


(4) casing PVC 40'  
 (material) (depth)  
 (size) If telescope see back.

(5) screen 5' 40'  
 (length) (depth to top)  
2" PVC  
 (size) (material)

(6) pump 1 7  
 (HP) (yield gpm)  
Elect  
 (type power)

(7) electric log no  
 (yes or no)  
 (organization running log)

(8) how well bottom plugged value

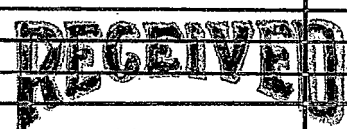


DEC 3 1976

DRILLERS REMARKS:

If well telescopes please sketch and show depths.

GROUND LEVEL

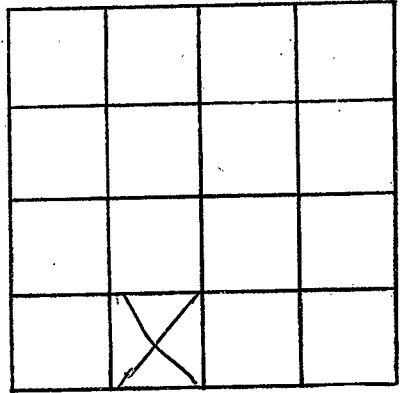

SECTION 8

Please indicate well location X.

ADDITIONAL INFORMATION

Lined area for additional information.

If more than one screen, show locations of each on sketch.