

Perry
 G 2004
 3-16-77

MISSISSIPPI
 BOARD OF WATER COMMISSIONERS
 416 North State Street
 130 Jackson, Mississippi 39201

WATER WELL DRILLERS LOG

3-16-77 date well completed
 1977 firm name
 Perry county well located


LANDOWNER:	description of formations encountered	from	to
Perry made R.F.D. 2	clay	0	12
(mailing address)	fine sand	12	20
WELL LOCATION: sec. 6 T. 3 N. R. 16 E. S W	fine gravel sand	20	35
10 miles S.E. of Pital (distance) (direction) (nearest town)			
WELL PURPOSE: (home, irrigation, municipal, industrial)			
WELL COMPLETION DATA:			
(1) diameter (inches) 2"			
(2) total depth (feet) 35 ft			
(3) static water level (feet) 6 ft below top of ground.			
(4) casing plastic 30 ft (material) (depth) 2" (size) if telescope see back.			
(5) screen 5 ft 35 ft (length) (depth to top) 2" plastic (size) (material)			
(6) pump 1 8 (HP) (yield gpm) jet (type power)			
(7) electric log (yes or no)			
(organization running log)			
(8) how well bottom plugged blue			
DRILLERS REMARKS:			

RECEIVED
 MAR 30 1977

MISS. BD. OF WATER COMMISSIONERS

If well telescopes please sketch and show depths.

GROUND LEVEL

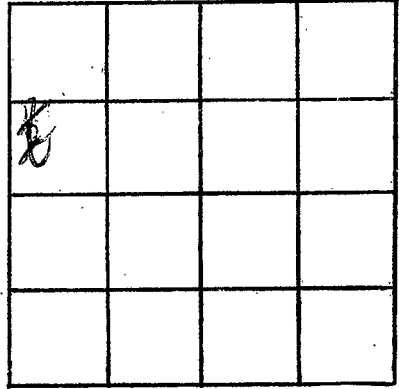

SECTION _____

Please indicate well location X.

ADDITIONAL INFORMATION

If more than one screen,
show locations of each on sketch.